

**Purchasing Services** 

Post Office Box 2570 Waco, Texas 76702-2570 Phone: 254-750-8405

> Fax: 254-750-8063 <u>KaseyG@wacotx.gov</u> www.waco-texas.com

Date: 10/25/2022

RFP No: **2022-084** 

Commodity: Cameron Park Zoo Education Center & Vet Hospital

Purchasing Agent: Mr. Kasey Gamblin

Closing Time: 2:00 P.M. CST, Friday, November 18, 2022 Opening Time: 2:01 P.M. CST, Friday, November 18, 2022

RFP Opening Location: Operations Center, Purchasing Services Office, 1415 N. 4<sup>th</sup> St.,

Waco, TX 76707

#### **Addendum No: 1**

The above-mentioned RFP invitation has been changed in the following manner. **Sign and return addendum to the Purchasing Office by the closing time and date with your RFP response**. Returning this page signed by your authorized agent will serve to acknowledge this change. All other requirements of the invitation remain unchanged. If you have any questions, please call or stop by the Purchasing Office at the above address.

Firm:		 	
Address			
Signature of Person Authorized to Sign Bid:			
Signor's Name and Title (print or type):			
E-mail Address:			
Date:	Telephone:	Fax:	

# Perkins&Will

#### Addendum #1

To: Bidders			Date of Issuance: 10.25.2022		
From: Perkins	s&Will				Project Name: Cameron Park Zoo: Education Center & Vet Hospital
Owner: City	of Waco				Project Number: 185236.000
	⊠ Owner	☐ Contractor	□ Field	□ Consultant	☑ Other (explain): Bidders

This is an Addendum providing information for Bidder's incorporation into bids. The documents listed below provide additions, deletions, clarifications, or corrections to originally issued documents and are intended to replace or supplement original documents.

#### **Description:**

Civil: 4 sheets

**C1.1**: Domestic water meter vault removed from scope of project

**C1.2**: Domestic water meter vault removed from scope of project

C1.3: Domestic water meter vault removed from scope of project

**C2.1**: Domestic water meter vault removed from scope of project

#### **Architecture**: 3 sheets

A01-01: Domestic water meter vault removed from scope of project

A10-01: Clarification provided for catering prep 132 sink responsibility and grease interceptor requirements.

A17-01: Clarification provided for catering prep 132 sink responsibility and grease interceptor requirements.

**Structure**: 1 sheet

**\$60-10**: Clarification provided for restroom countertop support

1001 McKinney Street, Suite 1300 Houston, Texas 77002

www.perkinswill.com

#### Perkins&Will

#### Addendum

Cameron Park Zoo: Education Center & Vet Hospital

Date: 10/25/2022

#### Plumbing: 4 sheets

P10-01: Clarification provided for grease interceptor requirements in Catering prep 132

**P61-50:** Clarification provided for grease interceptor requirements in Catering prep 132. Clarification provided for underfloor piping support requirements.

**P62-01:** Clarification provided for grease interceptor requirements.

**PU10-01:** Modifications to accommodate future grease interceptor. Modifications to coordinate with structural grade beams.

#### **Attachments:**

- (12) Drawing sheets, listed above
- (1) Specification section: 22 14 00 Grease Waste and Vent System

End of Addendum

# **PROJECT MANUAL**

Addendum #1

25 October 2022

# CAMERON PARK ZOO EDUCATION CENTER & VET HOSPITAL

**WACO, TEXAS** 

Perkins&Will Project Number: 185236.000



1001 McKinney St., Suite 1300 Houston, Texas 77002 | 713.366.4000

Cameron Park Zoo: Education Center & Vet Hospital

Waco, Texas Addendum #1 Perkins&Will 185236.000 25 October 2022

#### **DOCUMENT 00 01 07**

#### PROFESSIONAL SEALS PAGE

The following Specification Sections have been prepared by or under the direct supervision of the Mechanical Engineer:

MECHANI CAL ENGINEER Affiliated Engineers, Inc. One Greenway Plaza #150 Houston, Texas 77046

**SPECIFICATIONS** 

DIVISION 22 - PLUMBING
22 14 00 Grease Waste and Vent System



END OF DOCUMENT

Cameron Park Zoo: Education Center & Vet Hospital Perkins&Will Waco, Texas 185236.000 Issue for Bid and Permit 01 April 2022 25 October 2022 Addendum #1 **DOCUMENT 00 01 10** TABLE OF CONTENTS INDEX OF ISSUES NUMBER TITLE \_\_\_\_ISSUE DATE VOLUME 1 OF 2 INTRODUCTORY INFORMATION Title Page......01 Apr 22 00 01 01 00 01 07 Professional Seals Pages ......25 Oct 22 PROCUREMENT AND CONTRACTING REQUIREMENTS GROUP DIVISION 00 - PROCUREMENT AND CONTRACTING REQUIREMENTS PROCUREMENT REQUIREMENTS 00 26 00 Procurement Substitution Procedures......01 Apr 22 00 31 32 Soil and Groundwater Management Plan ...09 Sep 22 CONTRACTING REQUIREMENTS 00 52 13 Standard Form of Agreement between Owner and Contractor by reference only, document is not bound in the Project Manual 00 72 13 General Conditions of the Contract for Construction by reference only, document is not bound in the Project Manual SPECIFICATIONS GROUP

#### GENERAL REQUIREMENTS SUBGROUP

#### DIVISION 01 – GENERAL REQUIREMENTS

01 10 00	Summary01 Apr 22
01 22 00	Unit Prices01 Apr 22
01 23 00	Alternates01 Apr 22
01 25 00	Substitution Procedures

Cameron Park Zoo: Education Center & Vet Hospital	Perkins&Will
Waco, Texas	185236.000
Issue for Bid and Permit	01 April 2022
Addendum #1	25 October 2022

SECTION NUMBER	SECTION TITLE	I SSUE DATE	
01 26 00 01 29 00 01 31 00 01 32 00 01 32 33 01 33 00 01 40 00 01 42 00 01 50 00 01 58 13 01 60 00 01 73 00 01 73 29 01 77 00 01 78 23 01 78 39	Substitution Request Form Contract Modification Procedures	1 Apr 22 1 Apr 22	
01 79 00	Demonstration and Training	•	
	FACILITY CONSTRUCTION SUBGR	OUP	
DIVISION	02 – EXISTING CONDITIONS		
02 41 19	Selective Demolition0	1 Apr 22	
DIVISION	03 – CONCRETE		
03 10 00 03 15 26 03 20 00 03 30 00 03 54 16	Concrete Forming and Accessories0Under-Slab Sheet Vapor Barrier0Concrete Reinforcing0Cast-in-Place Concrete0Cement-Based Underlayment0	1 Apr 22 1 Apr 22 1 Apr 22	
DIVISION	04 – MASONRY		
04 20 00 04 22 00	Unit Masonry 0 Concrete Unit Masonry 0		
DIVISION 05 - METALS			
05 12 00 05 40 00 05 50 00 05 52 14	Structural Steel Framing0Cold-Formed Metal Framing0Metal Fabrications0Aluminum Pipe and Tube Railings0	1 Apr 22 1 Apr 22	
DIVISION 06 - WOOD, PLASTICS, AND COMPOSITES			
06 10 53 06 16 36	Miscellaneous Carpentry		

Cameron Park Zoo: Education Center & Vet Hospital Perkins&Will Waco, Texas 185236.000

Issue for Bid and Permit 01 April 2022

Addendum #1 25 October 2022

SECTION NUMBER	SECTION TITLE	I SSUE DATE
NOMBER	TTTLL	DAIL
06 16 43 06 18 00 06 40 23 06 41 16 06 61 16 06 83 16	Gypsum Sheathing	Apr 22 Apr 22 Apr 22 Apr 22
DIVISION	07 – THERMAL AND MOISTURE PROTECTION	
07 14 16 07 21 00 07 22 19	Cold Fluid Applied Waterproofing	Apr 22
07 27 26 07 41 13 07 54 23 07 62 00 07 65 26 07 71 00 07 84 13 07 84 43 07 92 00 07 92 19	Fluid-Applied Membrane Air Barriers	Apr 22 Apr 22 Apr 22 Apr 22 Apr 22 Apr 22 Apr 22 Apr 22 Apr 22
DIVISION	08 – OPENINGS	
08 11 13 08 12 19 08 14 16 08 31 13 08 32 20 08 41 13 08 44 13 08 44 33 08 62 23 08 63 00 08 71 00 08 71 13 08 80 00 08 81 13 08 87 33 08 91 19	Hollow Metal Doors and Frames	Apr 22
DIVISION	09 – FINISHES	
09 05 61.13 09 22 16 09 29 00 09 30 13	Moisture Vapor Emission Control	Apr 22 Apr 22

Cameron Park Zoo: Education Center & Vet Hospital	Perkins&Will
Waco, Texas	185236.000
Issue for Bid and Permit	01 April 2022
Addendum #1	25 October 2022

SECTION NUMBER	SECTION TITLE	I SSUE DATE
09 51 13 09 61 16 09 65 13 09 65 18 09 65 19 09 67 23 09 68 13 09 84 33 09 91 00 09 93 00 09 96 00	Acoustical Panel Ceilings Concrete Floor Sealing Resilient Base and Accessories Resilient Sheet Rubber Flooring Resilient Tile Flooring Resinous Flooring Tile Carpeting Sound Absorbing Wall Units Painting Staining and Transparent Finishing High-Performance Coatings	01 Apr 22 01 Apr 22
DIVISION	10 - SPECIALTIES	
10 14 23 10 21 13 10 22 39 10 26 00 10 28 13 10 44 00 10 51 13	Panel Signage Plastic (HDPE) Toilet Compartments Folding Panel Partitions Wall Protection Toilet Accessories Fire Protection Specialties Metal Lockers	01 Apr 22 01 Apr 22 01 Apr 22 01 Apr 22 01 Apr 22
DIVISION	11 – EQUIPMENT	
11 53 00	Laboratory Equipment	01 Apr 22
12 24 13	12 – FURNI SHI NGS  Roller Window Shades	
DIVISION	13 – SPECIAL CONSTRUCTION	
13 18 50 13 21 26	Animal Caging Cold Storage Rooms	
DIVISION	14 - CONVEYING SYSTEMS - NOT USED	
DIVISIONS	S 15 - 19 - NOT USED	

#### VOLUME 2 OF 2

#### INTRODUCTORY INFORMATION

00 01 01	Title Page01	Apr 22
00 01 07	Professional Seals Pages01	Apr 22
00 01 10	Table of Contents01	Apr 22

Cameron Park Zoo: Education Center & Vet Hospital	Perkins&Will
Waco, Texas	185236.000
Issue for Bid and Permit	01 April 2022
Addendum #1	25 October 2022

SECTION SECTION ISSUE NUMBER TITLE DATE

#### FACILITY SERVICES SUBGROUP

DIVISION:	20 – GENERAL MECHANI CAL		
20 00 00	General Mechanical Requirements	)1 Apr	22
20 05 13	Motors	)1 Apr	22
20 05 14	Variable Frequency Drive (VFD) System		
20 05 20	Excavation and Backfill		
20 05 29	Piping and Equipment Supporting Devices(		
20 05 53 20 07 00	Mechanical Systems Identification		
20 07 00	Mechanical Systems Insulation	л Арг	22
DIVISION	21 – FIRE SUPPRESSION		
21 00 00	General Fire Suppression Requirements	)1 Apr	22
21 13 14	Automatic Fire Sprinkler System	)1 Apr	22
DIVISION	22 – PLUMBI NG		
22 00 00	General Plumbing Requirements	)1 Apr	22
22 05 94	Domestic Water Systems Balance	)1 Apr	22
22 11 18	Water Distribution System		
22 13 14	Sanitary Waste and Storm Drainage Systems (	)1 Apr	22
22 14 00	Grease Waste and Vent System		
00 01 11	Addendum #1		
22 21 14	Plumbing Specialties	)1 Apr	22
22 33 14 22 40 00	Water Heating Equipment	11 Apr	22
22 62 14	Laboratory Vacuum Piping System		
	zazoratory rabaam riping byetem minimi		
	23 – HEATING, VENTILATING, AND AIR CONI	OITIC	NING
(HVAC)			
23 00 00	General HVAC Requirements		
23 05 50	Vibration Isolation		
23 05 95 23 09 03	Air Systems Testing, Adjusting, and Balancing(		
23 09 03	Control Instrumentation	11 Api 11 Apr	22
23 09 23	Control Sequences		
23 21 16	Pipe and Pipe Fittings		
23 23 14	Refrigeration Systems	)1 Apr	22
23 31 14	Ductwork	)1 Apr	22
23 33 14	Ductwork Specialties	)1 Apr	22
23 34 00	Fans		
23 36 00 23 37 13	Air Terminal Devices		
ZJ J/ IJ	DITUSELS, NEUISTELS, ATTA GHILES	ノエハレ	~~

Cameron Park Zoo: Education Center & Vet Hospital Perkins&Will Waco, Texas 185236.000

Issue for Bid and Permit 01 April 2022

Addendum #1 25 October 2022

SECTION NUMBER	SECTION TITLE	I SSUE DATE
23 41 14 23 74 00 23 81 27	Filters	)1 Apr 22
DIVISIONS	5 24 - 25 - NOT USED	
DIVISION 2	26 – ELECTRI CAL	
26 00 00 26 01 26 26 01 91	General Electrical Requirements	
26 05 16 26 05 19	Requirements	)1 Apr 22
26 05 26 26 05 29 26 05 33 26 05 33.13	and Cables	)1 Apr 22 )1 Apr 22 )1 Apr 22
26 05 43 26 05 43.13	Underground Ducts and Raceways for Electrical Systems	)1 Apr 22
26 05 43.19 26 05 53 26 05 73		)1 Apr 22 )1 Apr 22
26 05 93 26 08 12 26 08 13	Electrical Systems Firestopping	)1 Apr 22 )1 Apr 22
26 09 23 26 22 00 26 24 16.13	Lighting Control Devices	)1 Apr 22 )1 Apr 22
26 24 16.16 26 27 13 26 27 26		)1 Apr 22 )1 Apr 22
26 28 13 26 28 16 26 32 13	Fuses	)1 Apr 22 )1 Apr 22 )1 Apr 22
23 36 23 26 41 13 26 43 00	Automatic Transfer Switches	)1 Apr 22 )1 Apr 22
26 50 00	Lighting	

Waco, Texa	ark Zoo: Education Center & Vet Hospital s <del>d and Permit</del>		Perkins&Will 185236.000 — 01 April 2022
Addendum			25 October 2022
SECTION NUMBER	SECTION TITLE	ISSUE DATE	
	27 – COMMUNICATIONS		
27 00 00 27 05 26	General Communications Requirements0 Grounding and Bonding for Communications	•	
27 05 28.29	5	•	
27 05 28.3	9	•	
27 05 28.3	Systems0  Cable Trays for Communications Systems0		
27 05 28.3	9 Surface Raceways for Communications	•	
27 05 53	Systems		
27 10 00	Structured Cabling	•	
27 11 00	Communications Equipment Room Fittings0		
27 13 00	Communications Backbone Cabling0	•	
27 15 00	Communications Horizontal Cabling0	1 Apr 22	
27 16 00	Communications Connecting Cords, Devices	1 4 22	
	and Adapters0	TApr 22	
DIVISION	28 – ELECTRONIC SAFETY AND SECURITY		
28 00 00	General Electronic Safety and Security		
20 10 00	Requirements		
28 10 00 28 20 00	Electronic Access Control	•	
28 31 13	Fire Detection and Alarm Systems		
	29 – NOT USED		
	SITE AND INFRASTRUCTURE SUBGRO	UP	
DIVISION	30 - NOT USED		
DIVISION	31 – EARTHWORK		
31 31 16	Termite Control0	1 Apr 22	
31 63 29	Drilled Concrete Piers and Shafts0	1 Apr 22	
	City of Waco Standard Civil Specifications for Const w.waco-texas.com/engineering-specifications.asp#		=0
DIVISION	32 – EXTERIOR IMPROVEMENTS		
32 31 29	Wood Fences and Gates	1 Apr 22	
	City of Waco Standard Civil Specifications for Const w.waco-texas.com/engineering-specifications.asp#		=0

#### RFP 2022-084 Cameron Park Zoo Education Center & Vet Hospital

Cameron Park Zoo: Education Center & Vet Hospital Perkins&Will Waco, Texas 185236.000

Issue for Bid and Permit 01 April 2022

Addendum #1 25 October 2022

SECTION SECTION ISSUE NUMBER TITLE DATE

#### **DIVISION 33 - UTILITIES**

Reference City of Waco Standard Civil Specifications for Construction: https://www.waco-texas.com/engineering-specifications.asp#gsc.tab=0

END OF TABLE OF CONTENTS

Perkins&Will 185236.000 25 October 2022

#### **SECTION 22 14 00**

#### **GREASE WASTE AND VENT SYSTEM**

#### PART 1 - GENERAL

#### 1.1 DESCRIPTION

A. This Section includes materials and methods for grease waste and vent piping within building and including piping to point of use grease interceptor inside building.

#### 1.2 RELATED WORK

- A. Section 20 0553 Mechanical Systems Identification
- B. Section 22 2114 Plumbing Specialties
- C. Section 22 4000 Plumbing Fixtures

#### 1.3 REFERENCE

A. Work under this Section is subject to requirements of Contract Documents including General Conditions, Supplementary Conditions, and sections under Division 01 General Requirements.

#### 1.4 QUALITY ASSURANCE

- A. Order piping with each length marked with manufacturer's name or trademark and type of pipe; with each shipping unit marked with purchase order number, metal or alloy designation, temper, size, and supplier's name.
- B. Installed material not meeting specification requirements must be replaced with material that meets these specifications without additional cost to Owner.

#### 1.5 DELIVERY, STORAGE, AND HANDLING

- A. Promptly inspect shipments to ensure material is undamaged and complies with Specifications.
- B. Cover pipe to prevent corrosion or deterioration while allowing sufficient ventilation to avoid condensation. Do not store materials directly on grade. Protect pipe, tube, and fitting ends from damage. End caps shall remain in place. Protect fittings by storage inside or by durable, waterproof, above ground packaging.
- C. Offsite storage agreements will not relieve Contractor from using proper storage techniques.
- D. Storage and protection methods must allow inspection to verify products.

#### 1.6 SUBMITTALS

- A. Manufacturer's technical data for the following:
  - 1. Pipe and fittings
  - 2. Joints

Perkins&Will 185236.000 25 October 2022

- 3. Cleanouts
- 4. Traps
- 5. Grease Interceptor

#### PART 2 - PRODUCTS

#### 2.1 MATERIALS

A. Materials herein specified shall be new, unless otherwise noted.

#### 2.2 PIPE, FITTINGS, AND JOINTS

- A. Interior Above Ground (Vent Pipe):
  - 1. Cast Iron
    - a. Pipe: Hubless cast iron pipe, ASTM A-888, CISPI 301, NSF certified with material test reports from marked with collective trademark of Cast Iron Soil Pipe Institute or receive prior approval by Engineer
    - b. Fittings: Hubless cast iron fittings, ASTM A-888, CISPI 301, NSF certified with material test reports from marked with collective trademark of Cast Iron Soil Pipe Institute or receive prior approval by Engineer.
    - c. Joints: Heavyweight Couplings: No-hub couplings with (0.060") thick stainless-steel clamps, FM 1680 Class 1, ASTM Standard C-1540 Mission Heavyweight, Husky Series 4000, Ideal Tridon "HD", or Clamp-All Hi-Torq 125.
- B. Adaptor Couplings for Joining Dissimilar Pipe Materials:
  - 1. Acceptable Manufacturers: Fernco, Mission
  - 2. (1" through 6") diameter: Fernco Proflex 3000 Series shielded coupling with neoprene gasket, stainless steel shield, and stainless-steel clamping bands. Adaptor couplings shall be specifically designed for pipe materials being joined.
  - 3. (8" through 10") diameter: Fernco 1000 Series flexible coupling with elastomeric PVC or neoprene gasket and stainless-steel clamping bands. Adaptor couplings shall be specifically designed for pipe materials being joined.

#### 2.3 CLEANOUTS

- A. Blucher, Josam, Smith, or Zurn, equal to number listed in Drains and Cleanout Schedule.
- B. Cleanout material shall be similar to pipe material.

#### 2.4 TRAPS

- A. Same material as pipe or fittings unless specified with fixtures. Refer to Section 22 4000 Plumbing Fixtures. Provide (17 ga) brass, chrome plated traps for exposed traps.
- 2.5 POINT OF USE HYDO-MECHANICAL GREASE INTERCEPTOR (OFOI)
  - A. Acceptable Manufacturers: Jay R. Smith MGF. Co., Zurn, and MiFab
  - B. Description: Steel interceptor with gray duco coating inside and outside with flow control fitting. Grease interceptor will be floor mounted and owner furnished, owner installed

Perkins&Will 185236.000 25 October 2022

C. Basis of design is JR Smith model # 8025 capable of accepting 25 gpm and holding 50 lbs of grease.

#### PART 3 - EXECUTION

#### 3.1 INSTALLATION - GENERAL

- A. Install pipe and fittings in accordance with reference standards, manufacturer's recommendations, and recognized industry practices.
- B. Provide rigid bracing to resist movement of upstream pipe for horizontal pipes (4") and larger with changes in direction greater than 45 degrees.
- C. Avoid cleanout plugs in ceiling cavities. Where cleanouts are required, extend pipe to floor cleanouts in slab above.
- D. Connect piping to fixtures, each piece of equipment, and drains. Install required piping as shown on drawings.
- E. Grade horizontal lines with minimum of (1/8" per ft), except piping (2") diameter or smaller which shall be run at (1/4" per ft) slope.
- F. Grade horizontal lines with minimum of (1/4" per ft), except piping (4") diameter or larger which may be run at (1/8" per ft) slope with approval of local authority.
- G. Install piping parallel with building lines and at heights, which do not obstruct any portion of window, doorway, stairway, or passageway, except, as may be shown on plans. Install overhead piping as high as possible.
- H. Grade vent pipe for complete drainage by gravity to soil or waste pipes. Vent terminations shall be set true and level. Locate vent piping at least (10 ft) away from window, door or intake openings. Coordinate closely with roofing contractor to prevent damage to roofing membrane. Flashing shall be in accordance with requirements of roofing manufacturer.
- I. Where interferences develop, offset, or reroute piping as required to clear interferences. Coordinate locations of plumbing piping with piping, ductwork, conduit, and equipment of other trades to allow sufficient clearances. Consult drawings for exact location of pipe spaces, ceiling heights, door and window openings, or other architectural details before installing piping.
- J. Provide protective sleeve covering of elastomeric pipe insulation, where piping and/or fittings are embedded in masonry or concrete.
- K. Maintain piping in clean condition internally during construction.
- L. Mitered ells, notched tees, and orange peel reducers are not allowed. Bushings are not allowed on threaded piping.
- M. Do not route piping through transformer vaults or above transformers, panelboards, or switchboards, including required service space for this equipment, unless piping is serving this equipment.
- N. Set cleanouts true and level and protect properly throughout construction.

Perkins&Will 185236.000 25 October 2022

- O. Set floor drains true and level and protect properly throughout construction. Weep holes shall be filled with removable material and kept free from concrete and other debris during construction. Weep holes shall be cleaned out for final working order. Provide safing for floor drains installed in elevated slabs.
- P. Provide plugs or caps for pipe openings during construction to prevent debris from entering pipe. Temporary plug shall be plastic cap or equivalent.

#### 3.2 UNDERGROUND WARNING TAPE

A. Provide warning tape for exterior buried sewers per Section 20 0553.

#### 3.3 STAINLESS STEEL PIPE

- A. Install stainless steel pipe and fittings as recommended by the manufacturer.
- B. Clean pipe end, bell, gasket seat and gasket of dirt or debris. Coat end of pipe and gasket with gasket lubricant. Use adhesive lubricant per manufacturers' recommendations on all piping larger than 4". Ensure pipe is supported off ground so lubricant does not pick up dirt. Push spigot end into end of gasket bell with levered pipe joining tool recommended by pipe manufacturer. Insert to fully seated position or to reference mark on pipe.
- C. Support piping at every coupling and at base of all stacks. Locate hanger within (18") of coupling.
- D. Installations with multiple joints within a (4 ft) developed length shall be supported at every second joint.
- E. Secure the base of risers with thrust restraints to prevent joint separation.
- F. Provide restraints for piping (5") and larger at all changes in direction and at all pipe size changes greater than 2 pipe sizes.

#### 3.4 CAST IRON PIPE

- A. Install cast iron pipe and fittings as recommended by CISPI in their publication "Installation of Cast Iron Soil Pipe and Fittings".
- B. No-hub Piping: Place gasket on end of one pipe of fitting and clamp assembly on end of other pipe or fitting. Firmly seat pipe or fittings ends against integrally molded shoulder inside neoprene gasket. Slide clamp assembly into position over gasket. Tighten fasteners to manufacturer's recommended torque.
- C. Support piping at every coupling and at base of all stacks. Locate hanger within (18") of coupling.
- D. Installations with multiple joints within a (4 ft) developed length shall be supported at every second joint.
- E. Provide restraints for piping (5") and larger at all changes in direction and at all pipe size changes greater than 2 pipe sizes.
- F. Brace horizontal piping (5") and larger to prevent horizontal movement. Install bracing at every branch connection and every change of direction in accordance with CISPI recommendations.

Perkins&Will 185236.000 25 October 2022


#### 3.5 THREADED PIPE


- A. Make joints for threaded pipe by cutting pipe square and reaming inside. Threads shall be cut so that end of pipe extends to shoulder of fitting.
- B. Exposed threads shall not exceed 3 in number and shall be painted with heavy coat of corrosion inhibiting material.
- C. Use only approved joint compounds, thread lubricant, or Teflon tape sparingly and only on outer threads.


#### 3.6 TESTING


- A. Refer to Testing paragraph of Section 20 0000 General Mechanical Requirements.
- B. Water test may be applied to system either in its entirety or in sections. Piping shall be tightly plugged and submitted to (10 ft) head of water located at highest point. Provide separate standpipe above highest point being tested or extend system to obtain required (10 ft) head of water. Head shall be maintained for at least 30 minutes before inspection starts.
- C. Defective work or material shall be replaced or repaired as necessary and inspection and test repeated. Repairs shall be made with new materials. No caulking of threaded joints or holes will be allowed.
- D. Do not backfill pipe until successfully tested.
- E. Testing with air will not be allowed.

**END OF SECTION** 

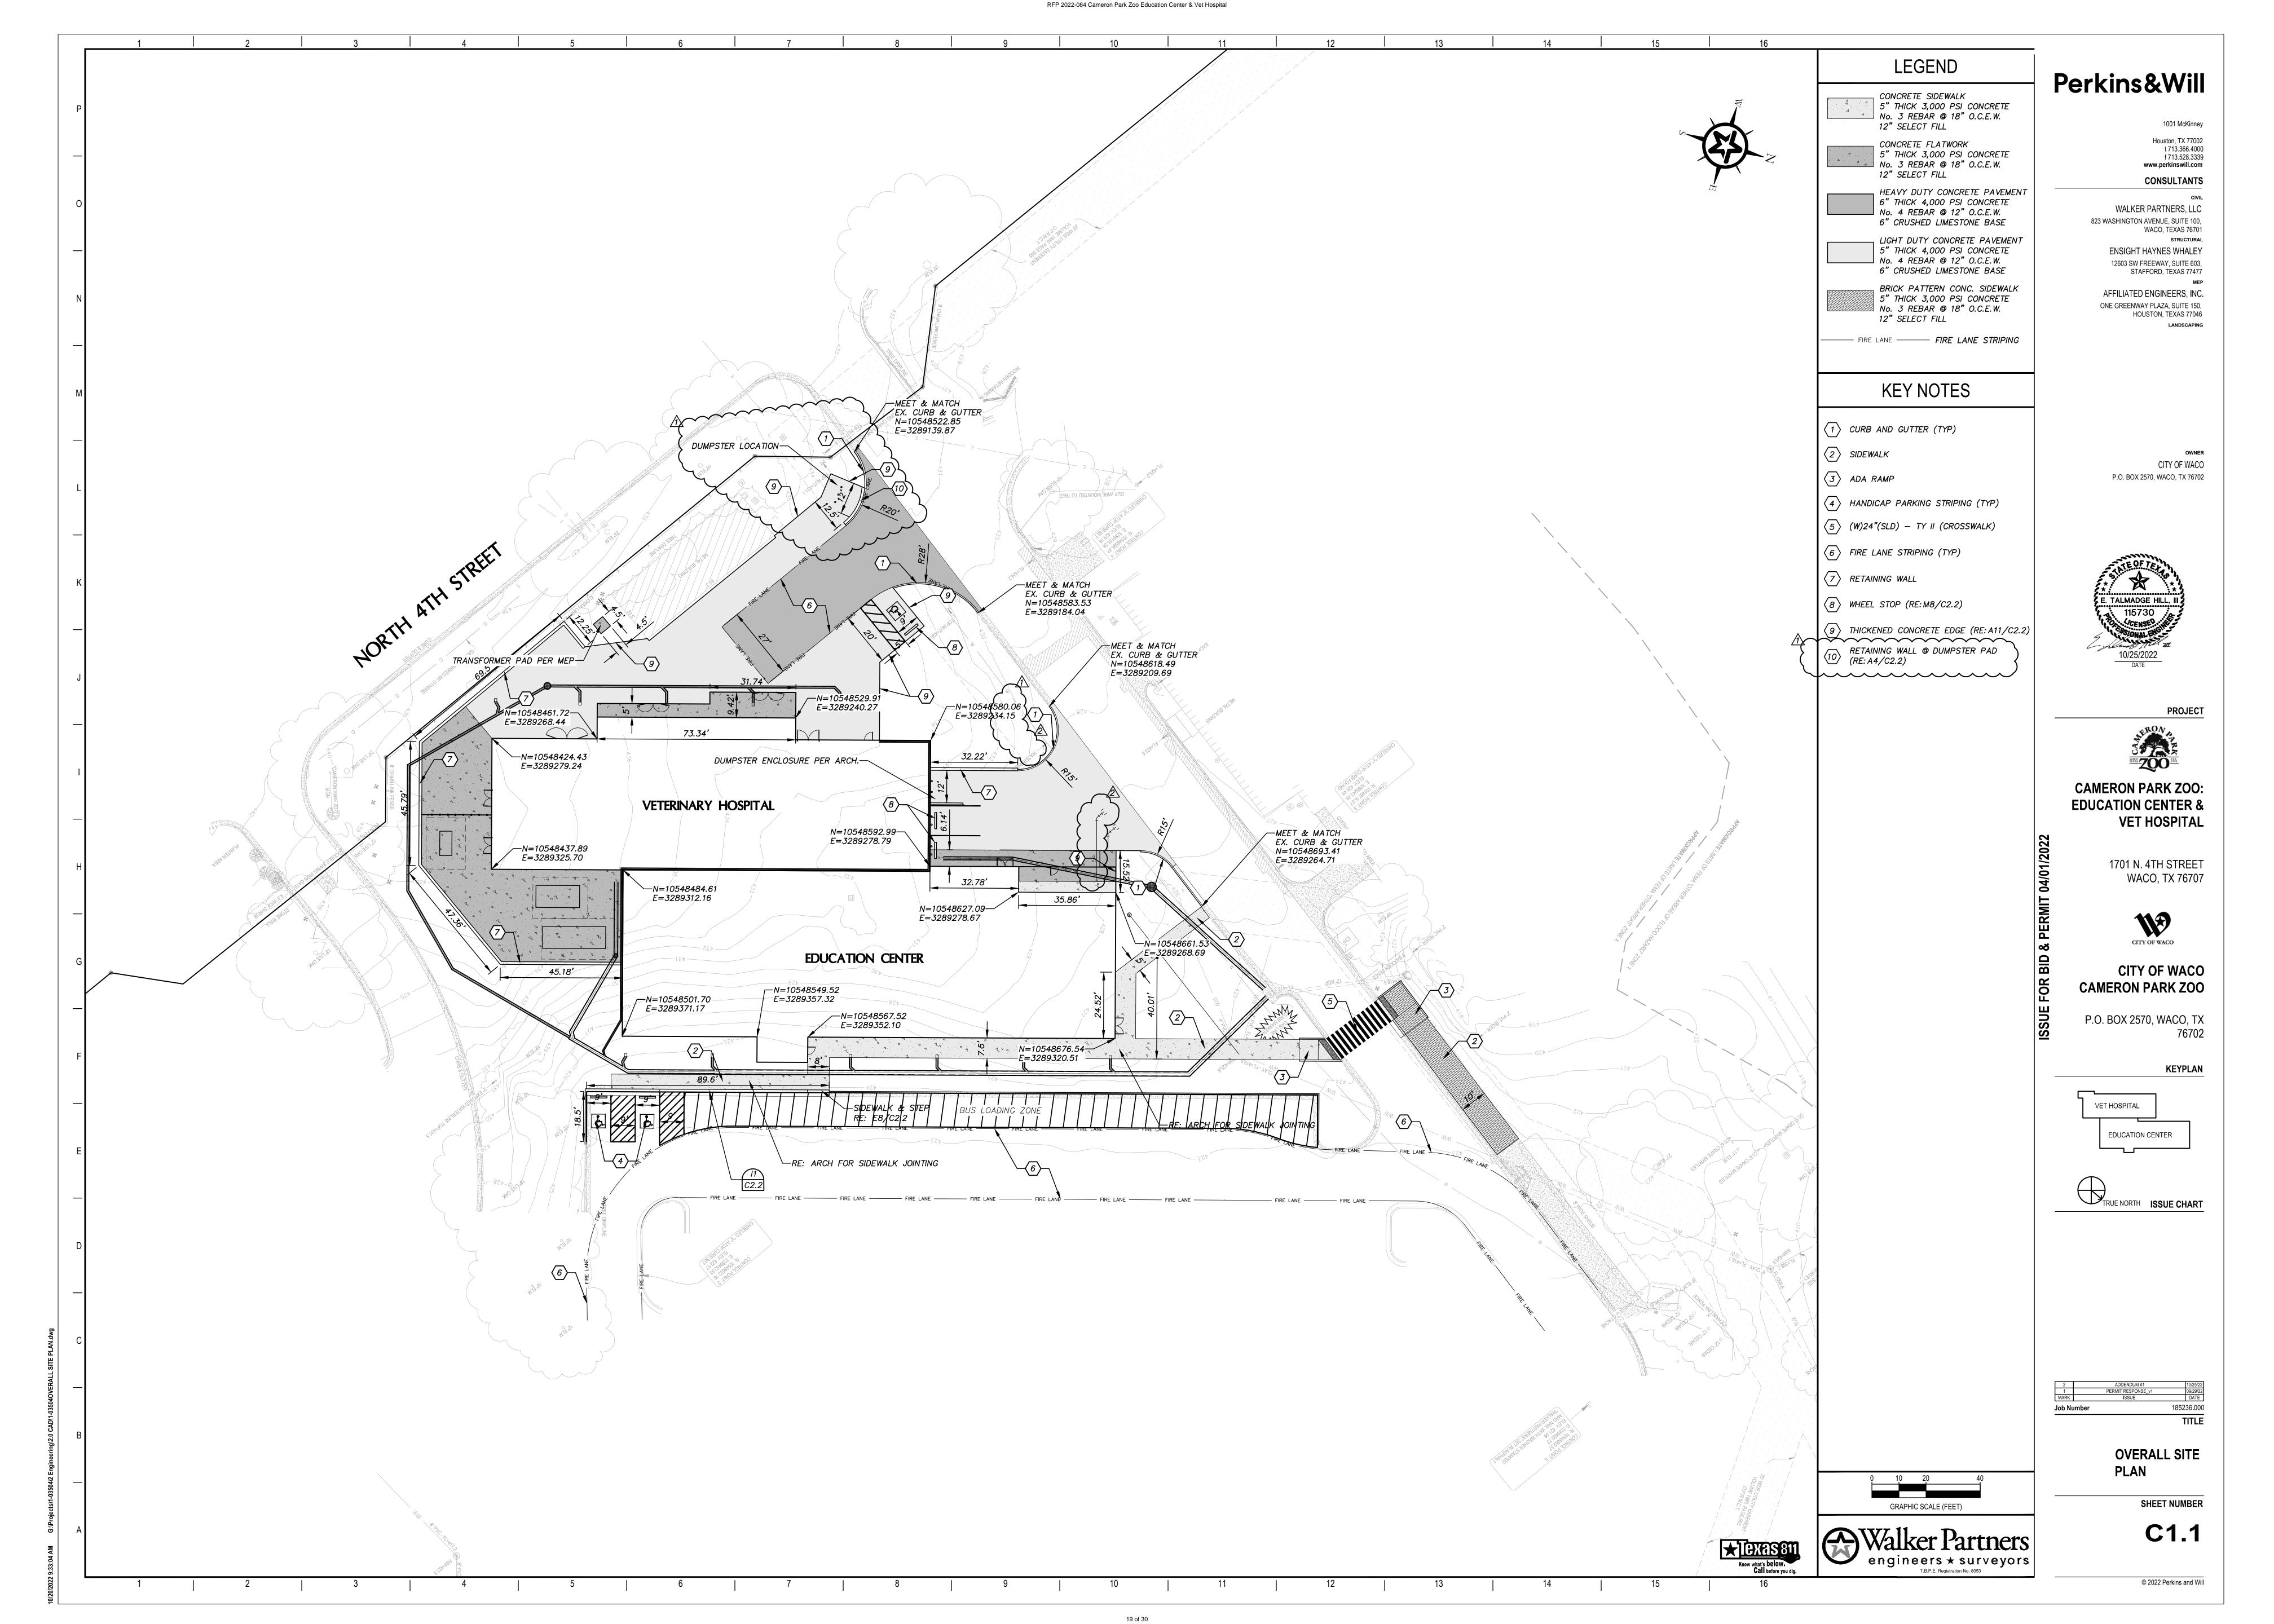

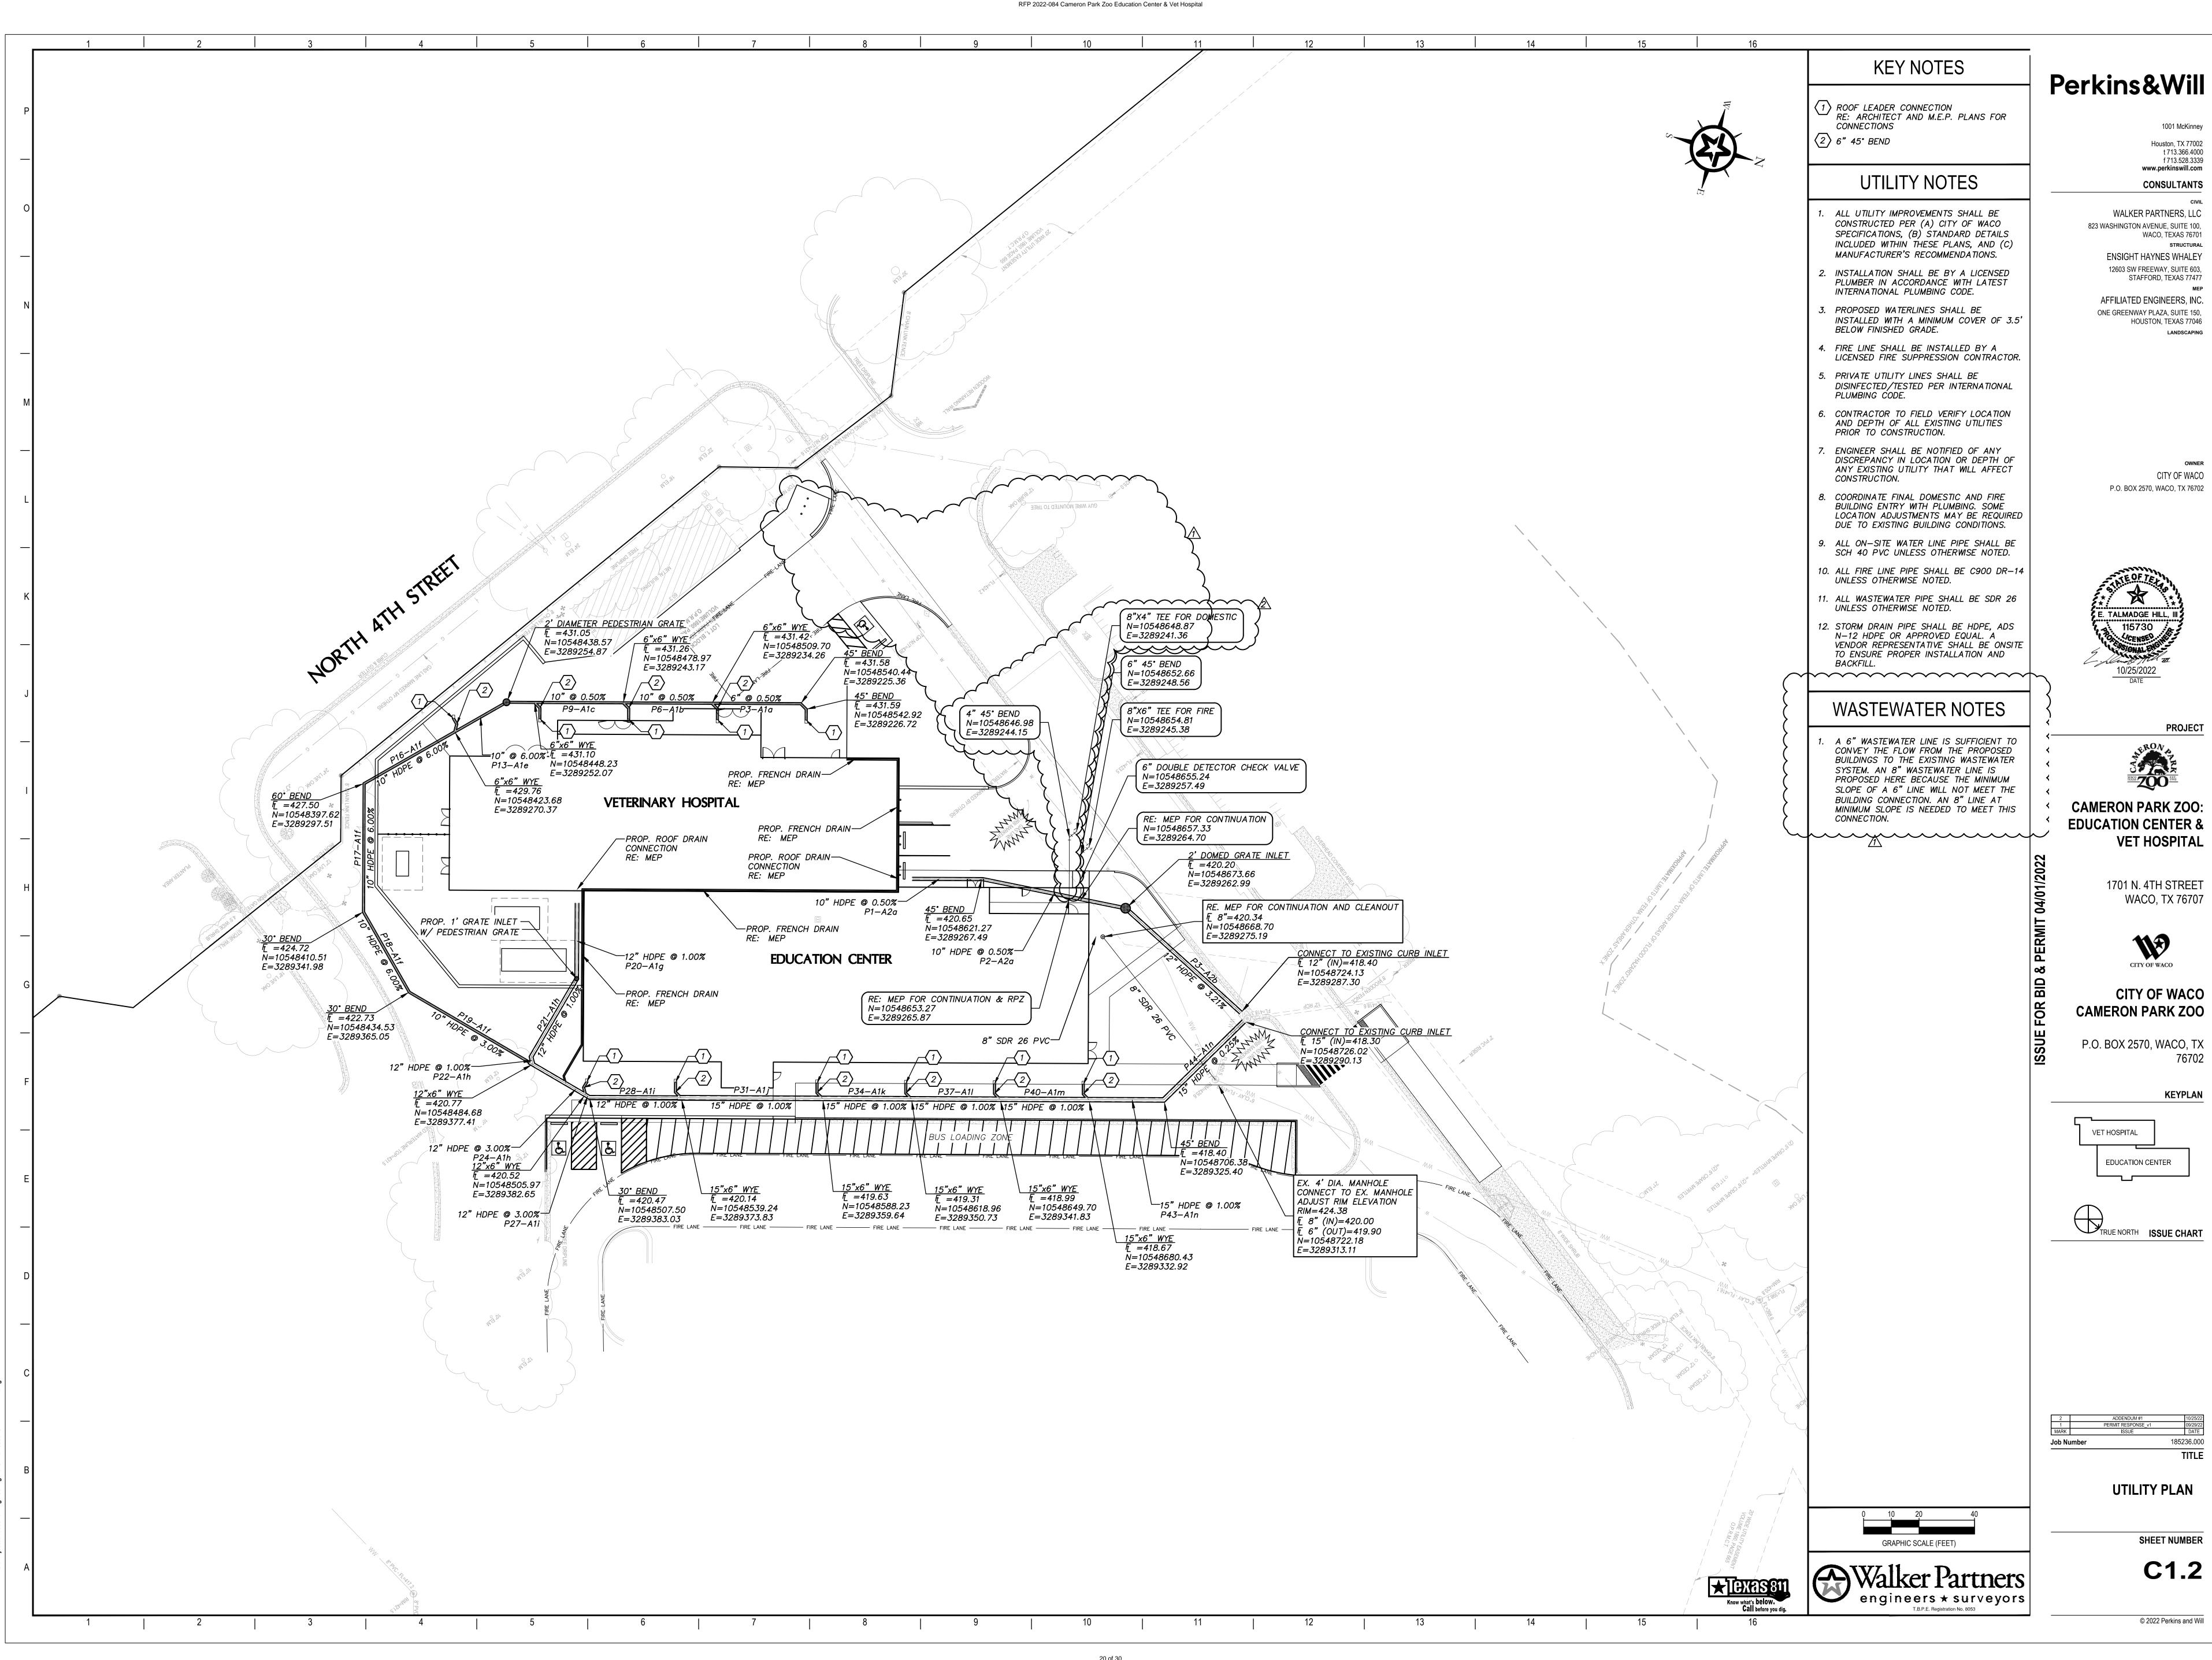

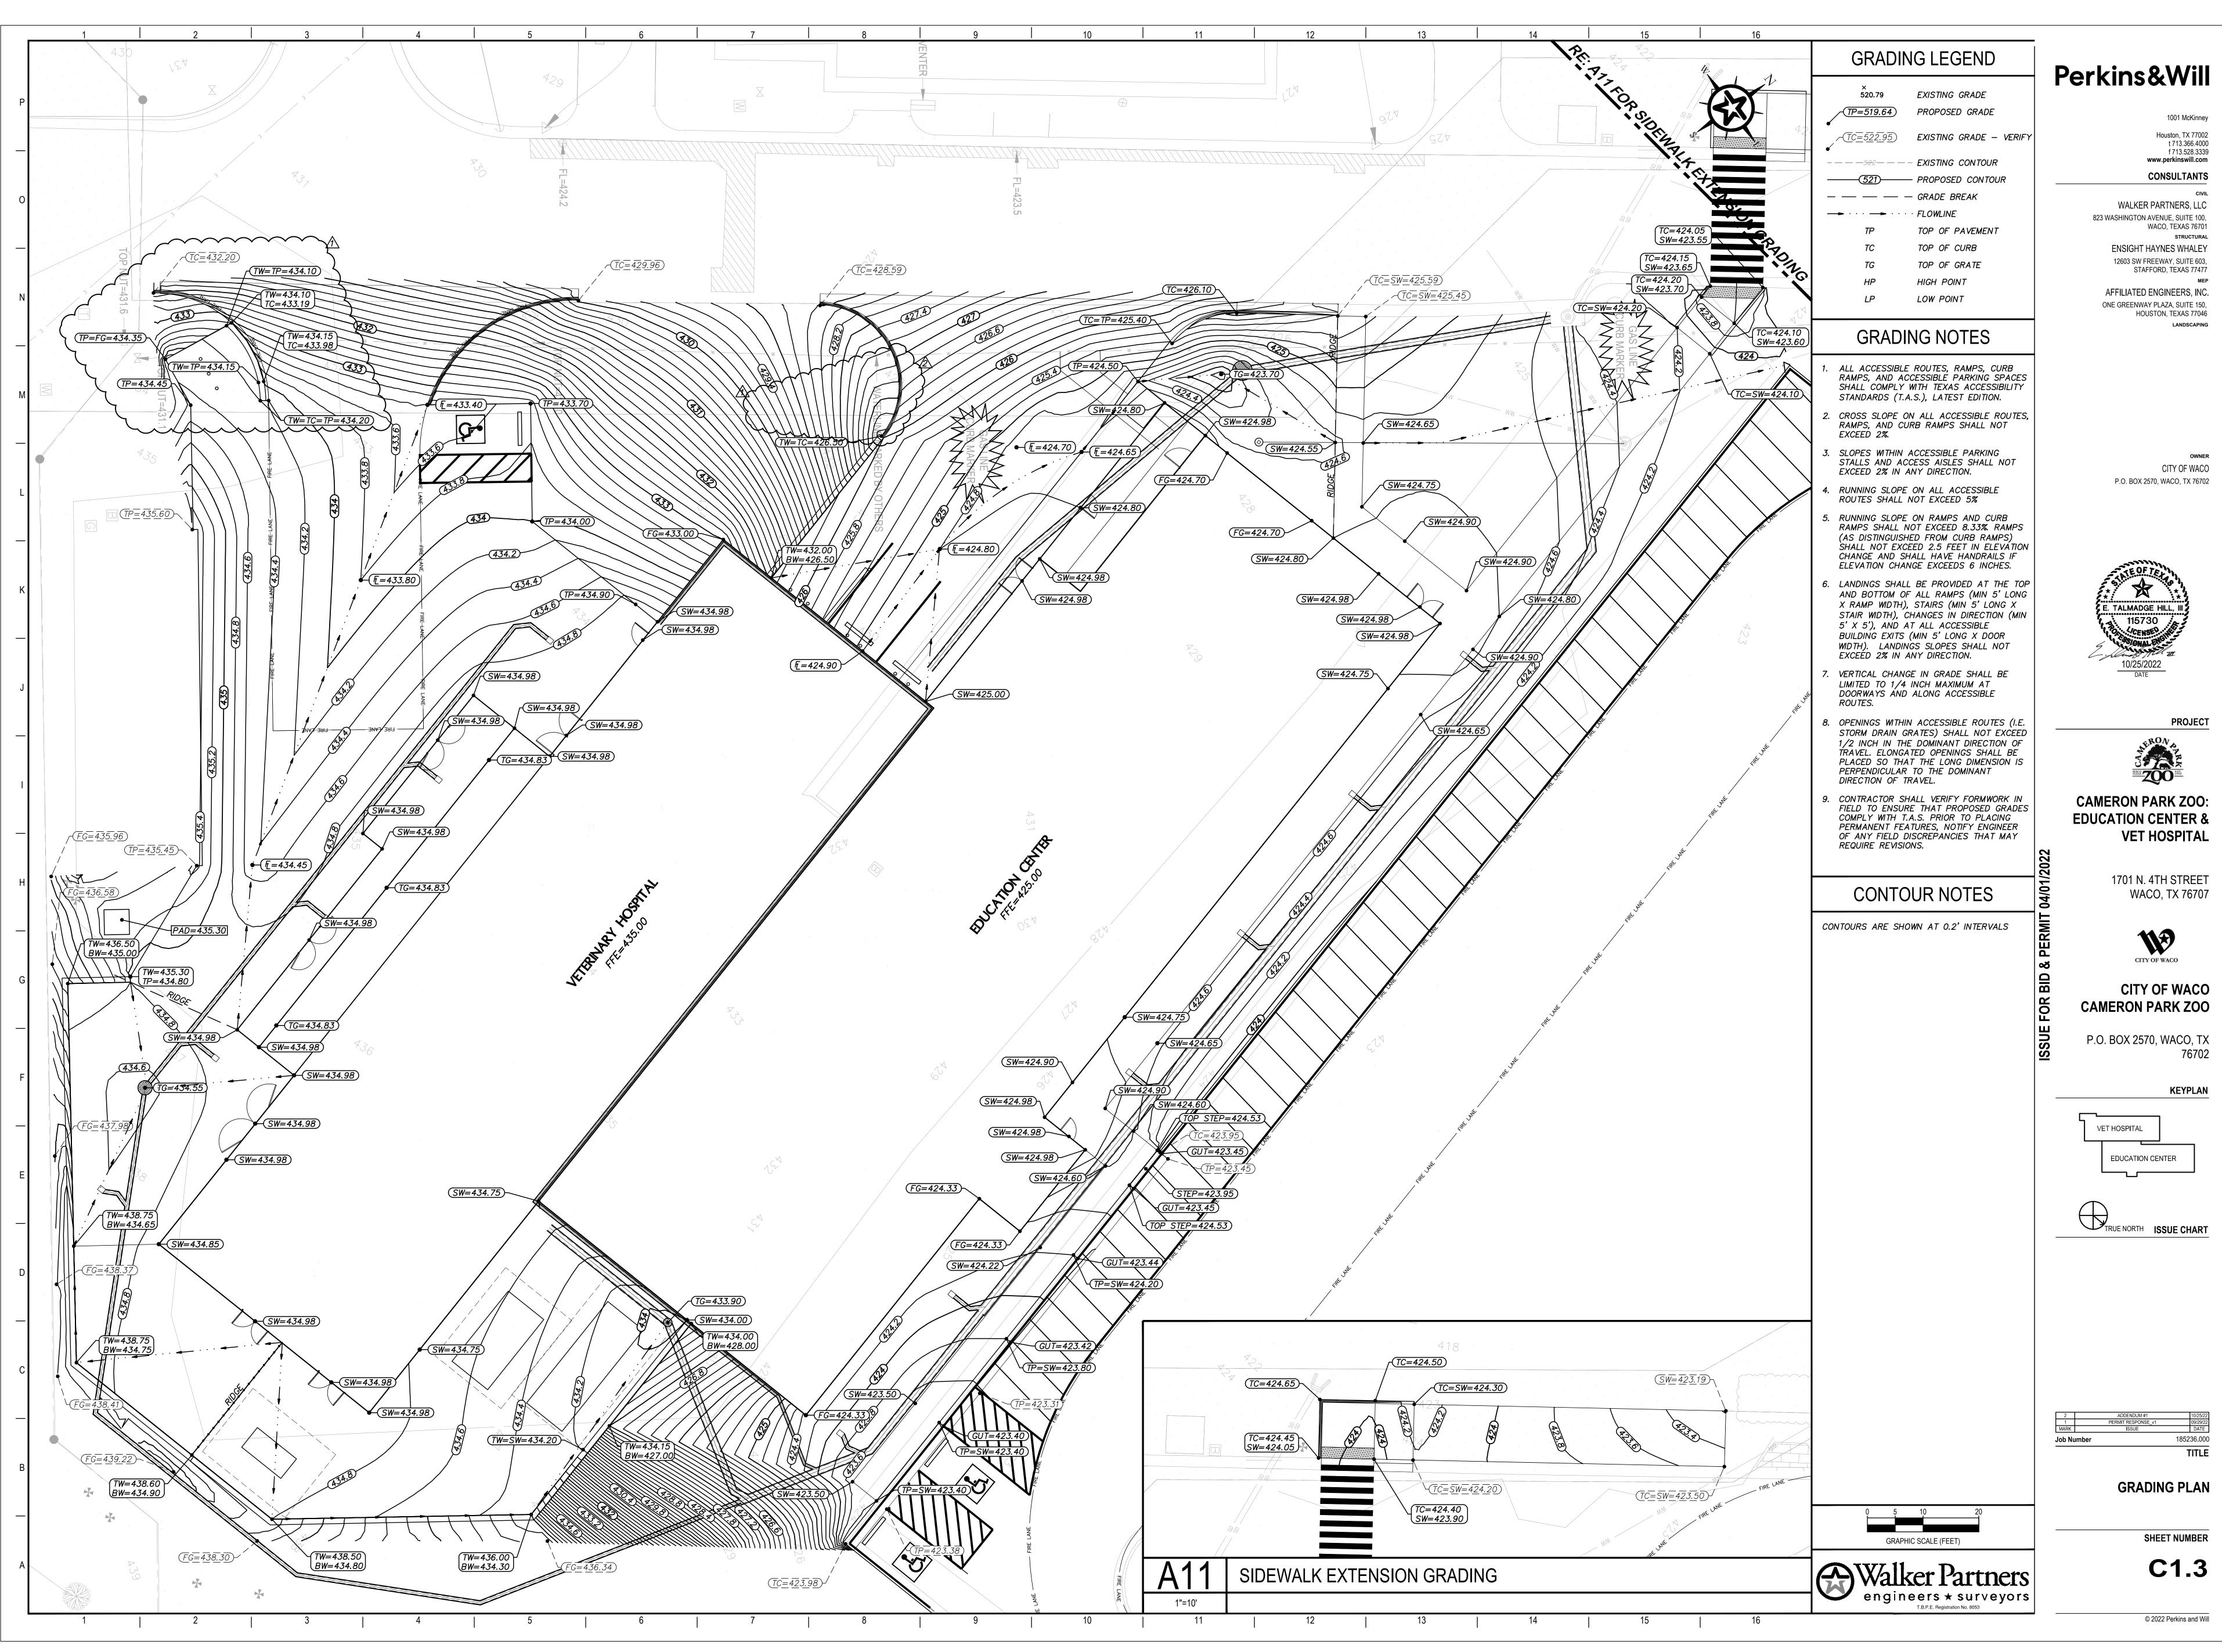

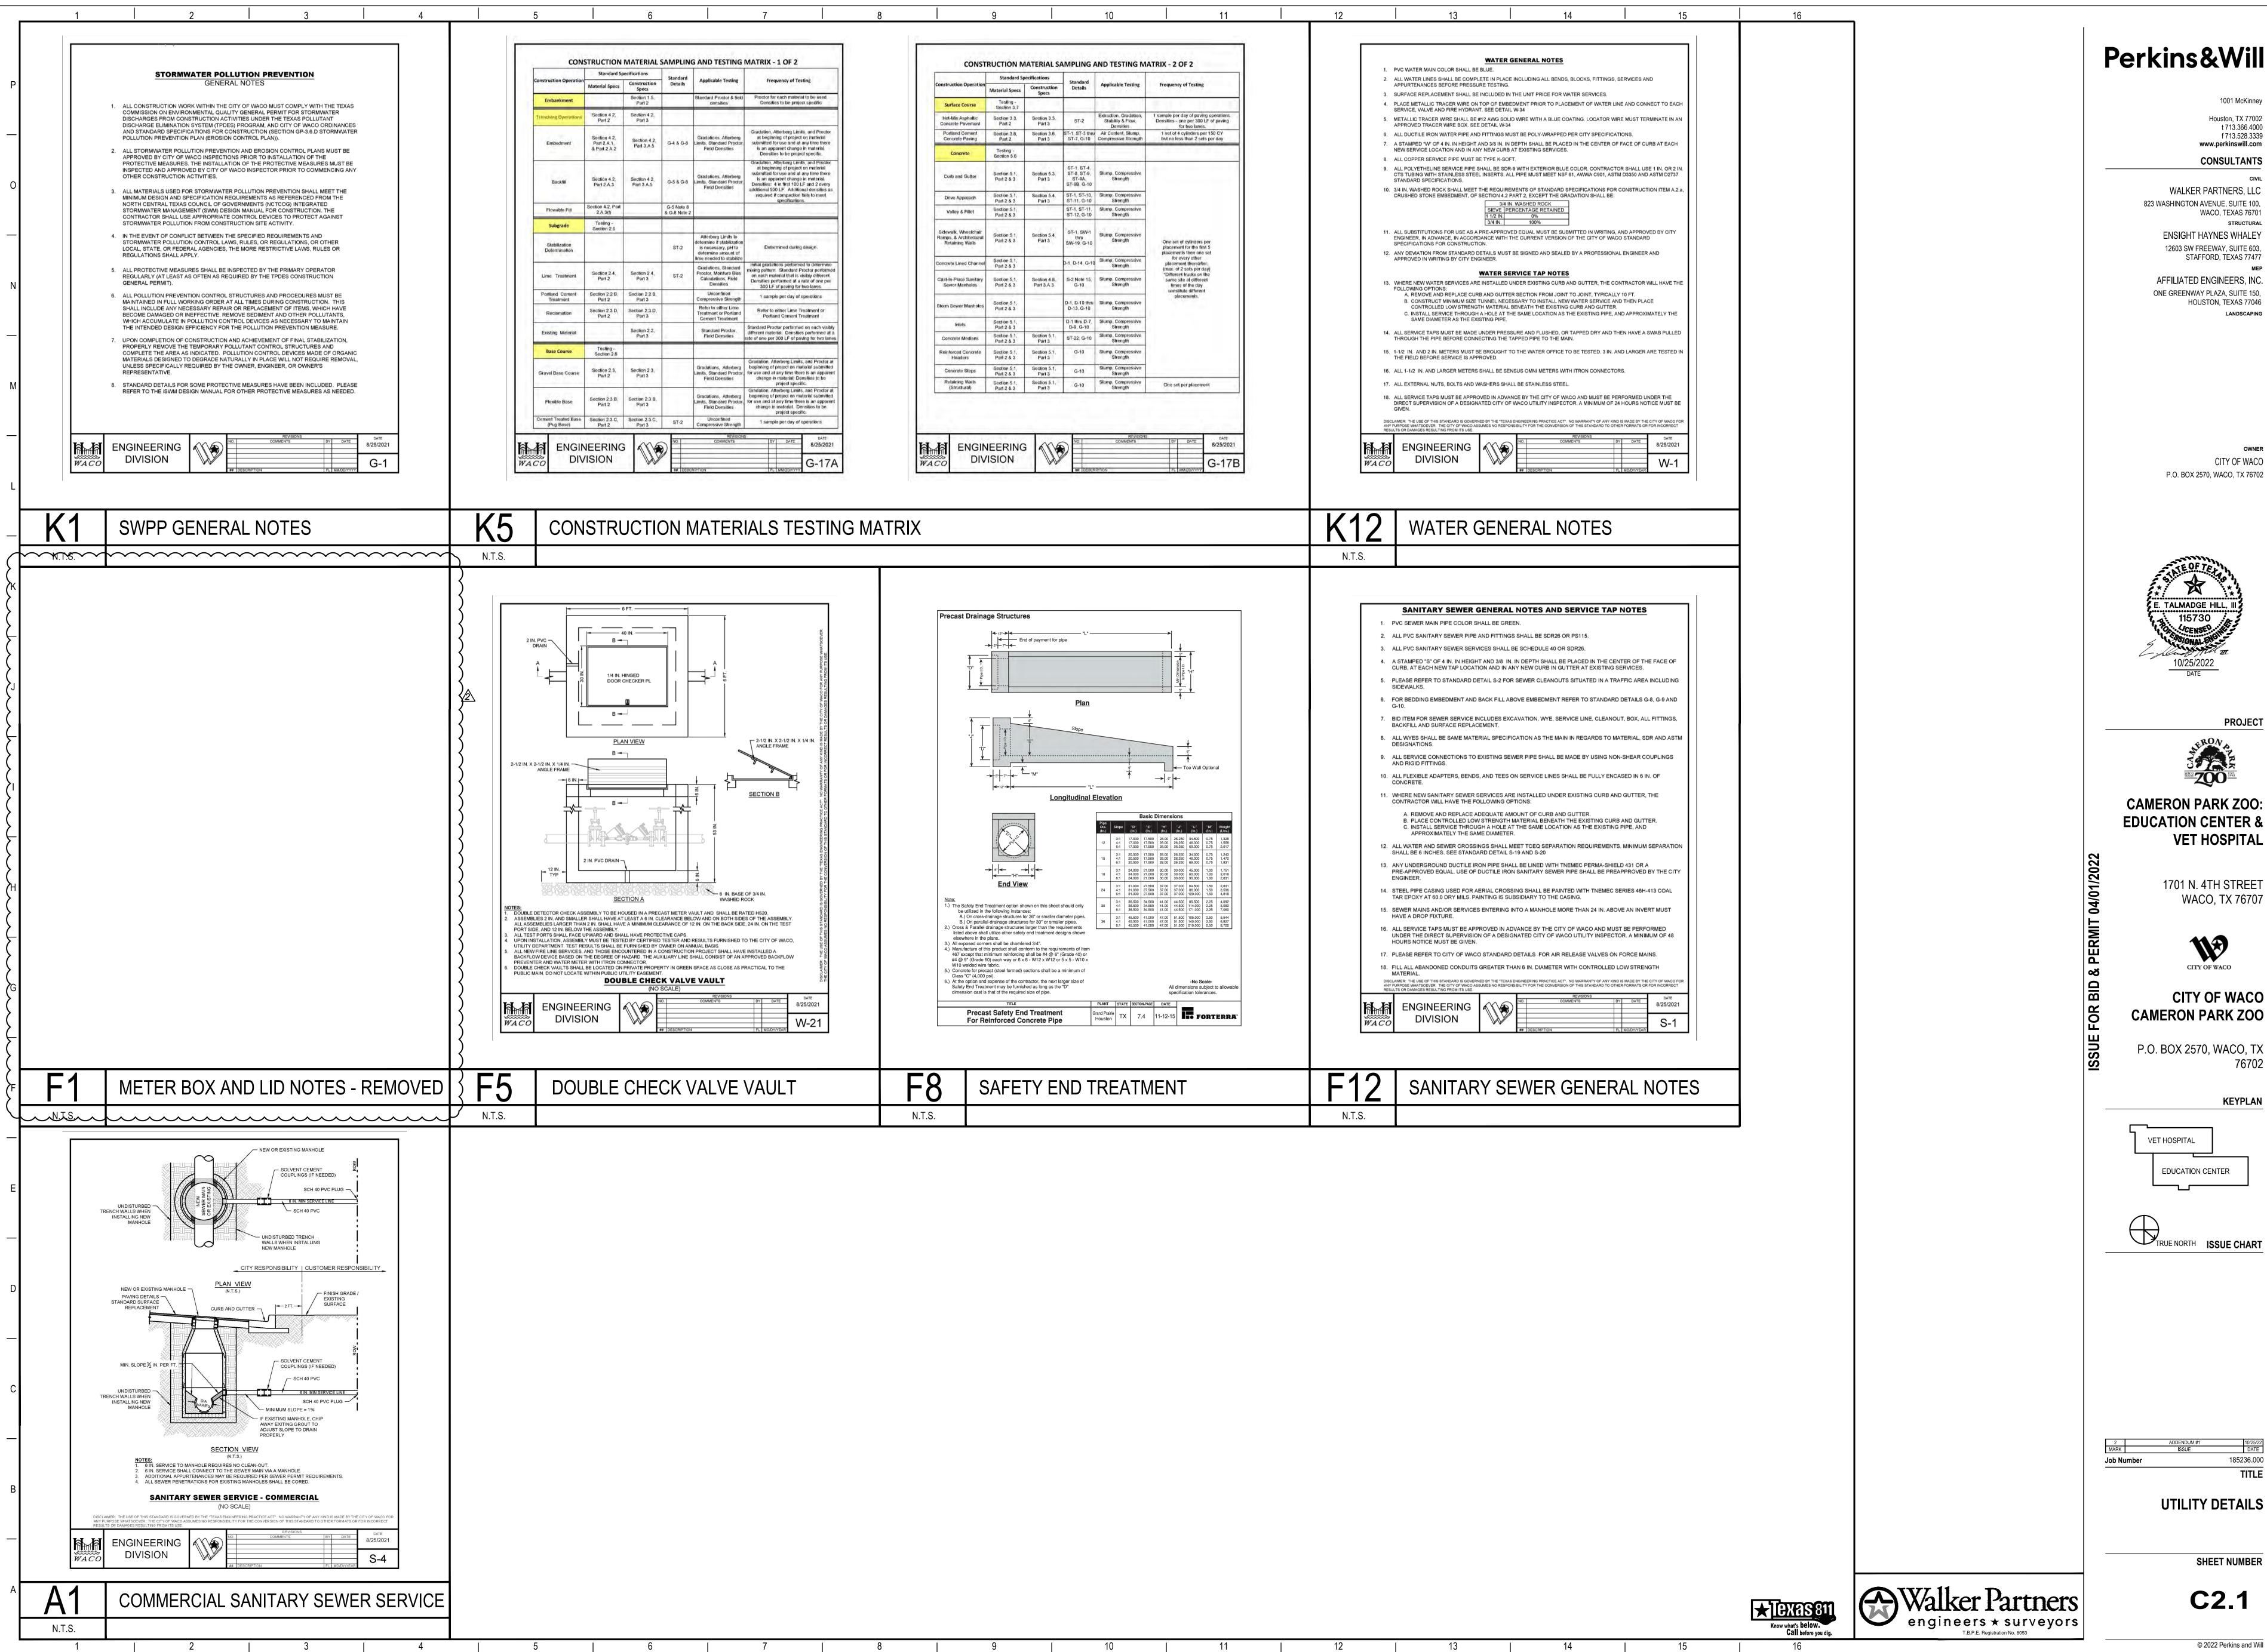

Perkins&Will

Houston, TX 77002 t 713.366.4000 f 713.528.3339

WALKER PARTNERS, LLC 823 WASHINGTON AVENUE, SUITE 100, WACO, TEXAS 76701

AFFILIATED ENGINEERS, INC. ONE GREENWAY PLAZA, SUITE 150, HOUSTON, TEXAS 77046

CITY OF WACO P.O. BOX 2570, WACO, TX 76702



**PROJECT** 



**CAMERON PARK ZOO: EDUCATION CENTER & VET HOSPITAL** 

> 1701 N. 4TH STREET WACO, TX 76707



**CITY OF WACO** 

P.O. BOX 2570, WACO, TX

**KEYPLAN** 

**EDUCATION CENTER** 




185236.000


**UTILITY DETAILS** 

SHEET NUMBER

**C2.1** 

© 2022 Perkins and Will

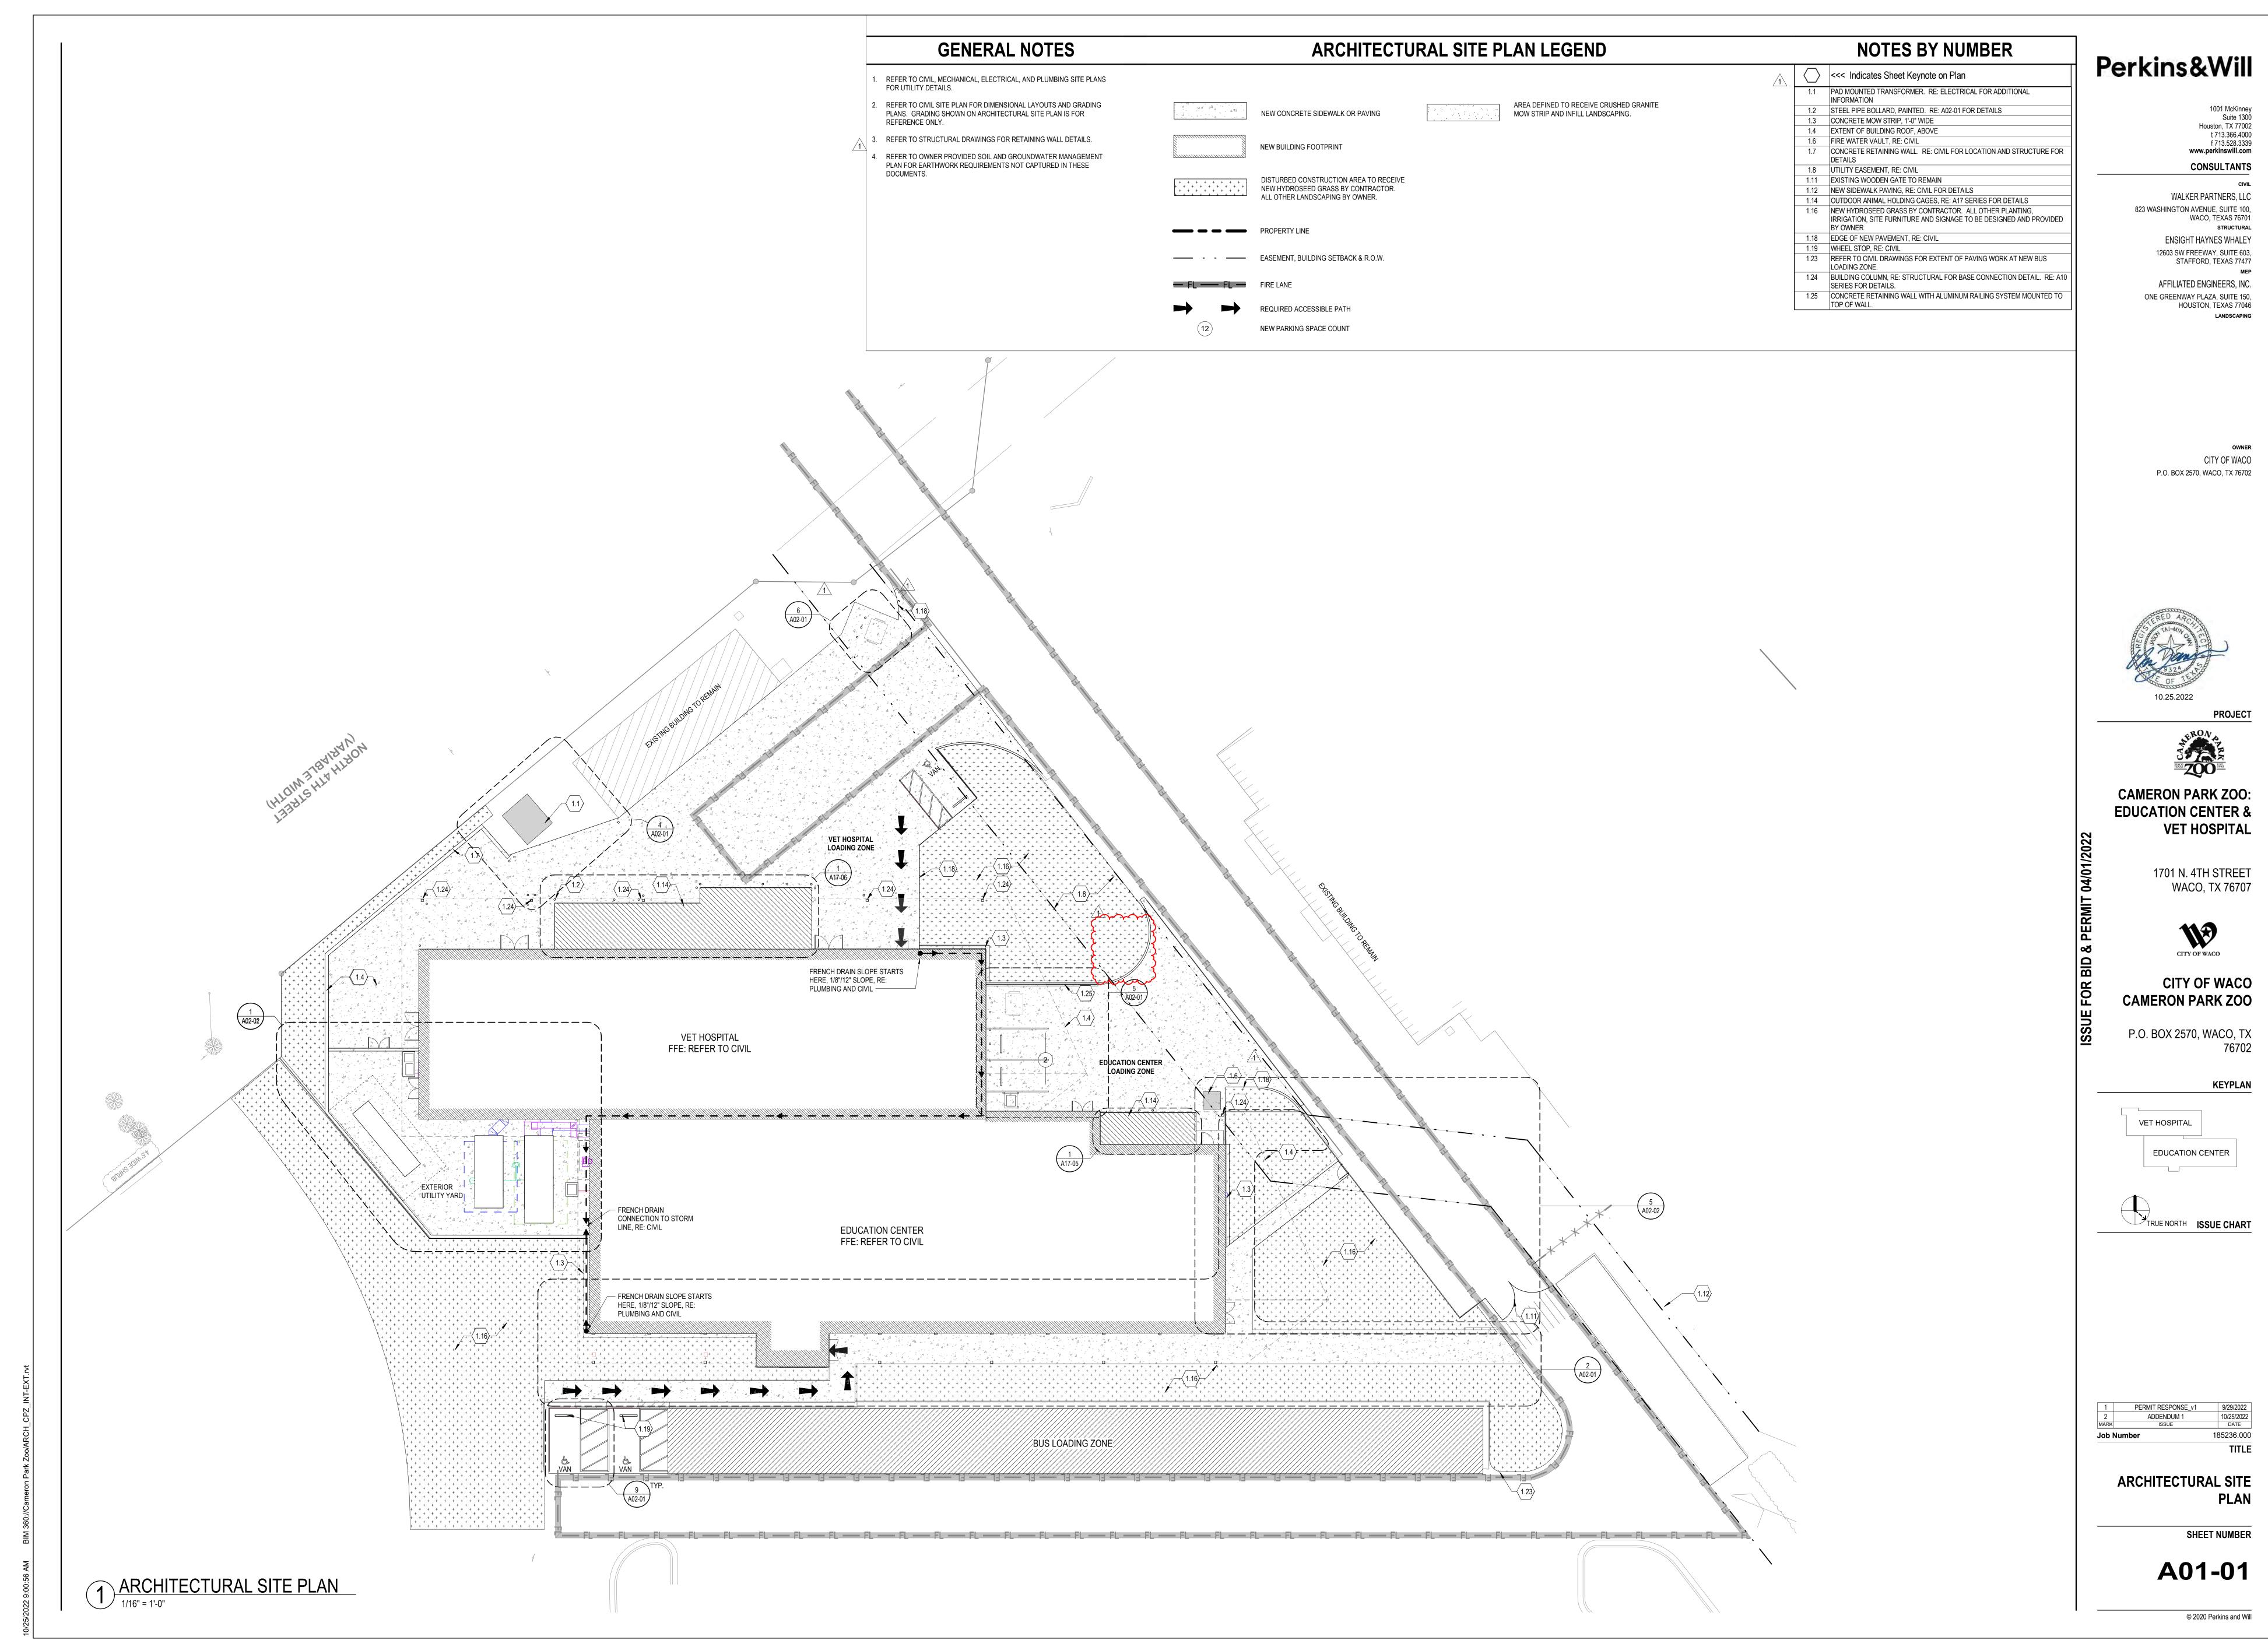

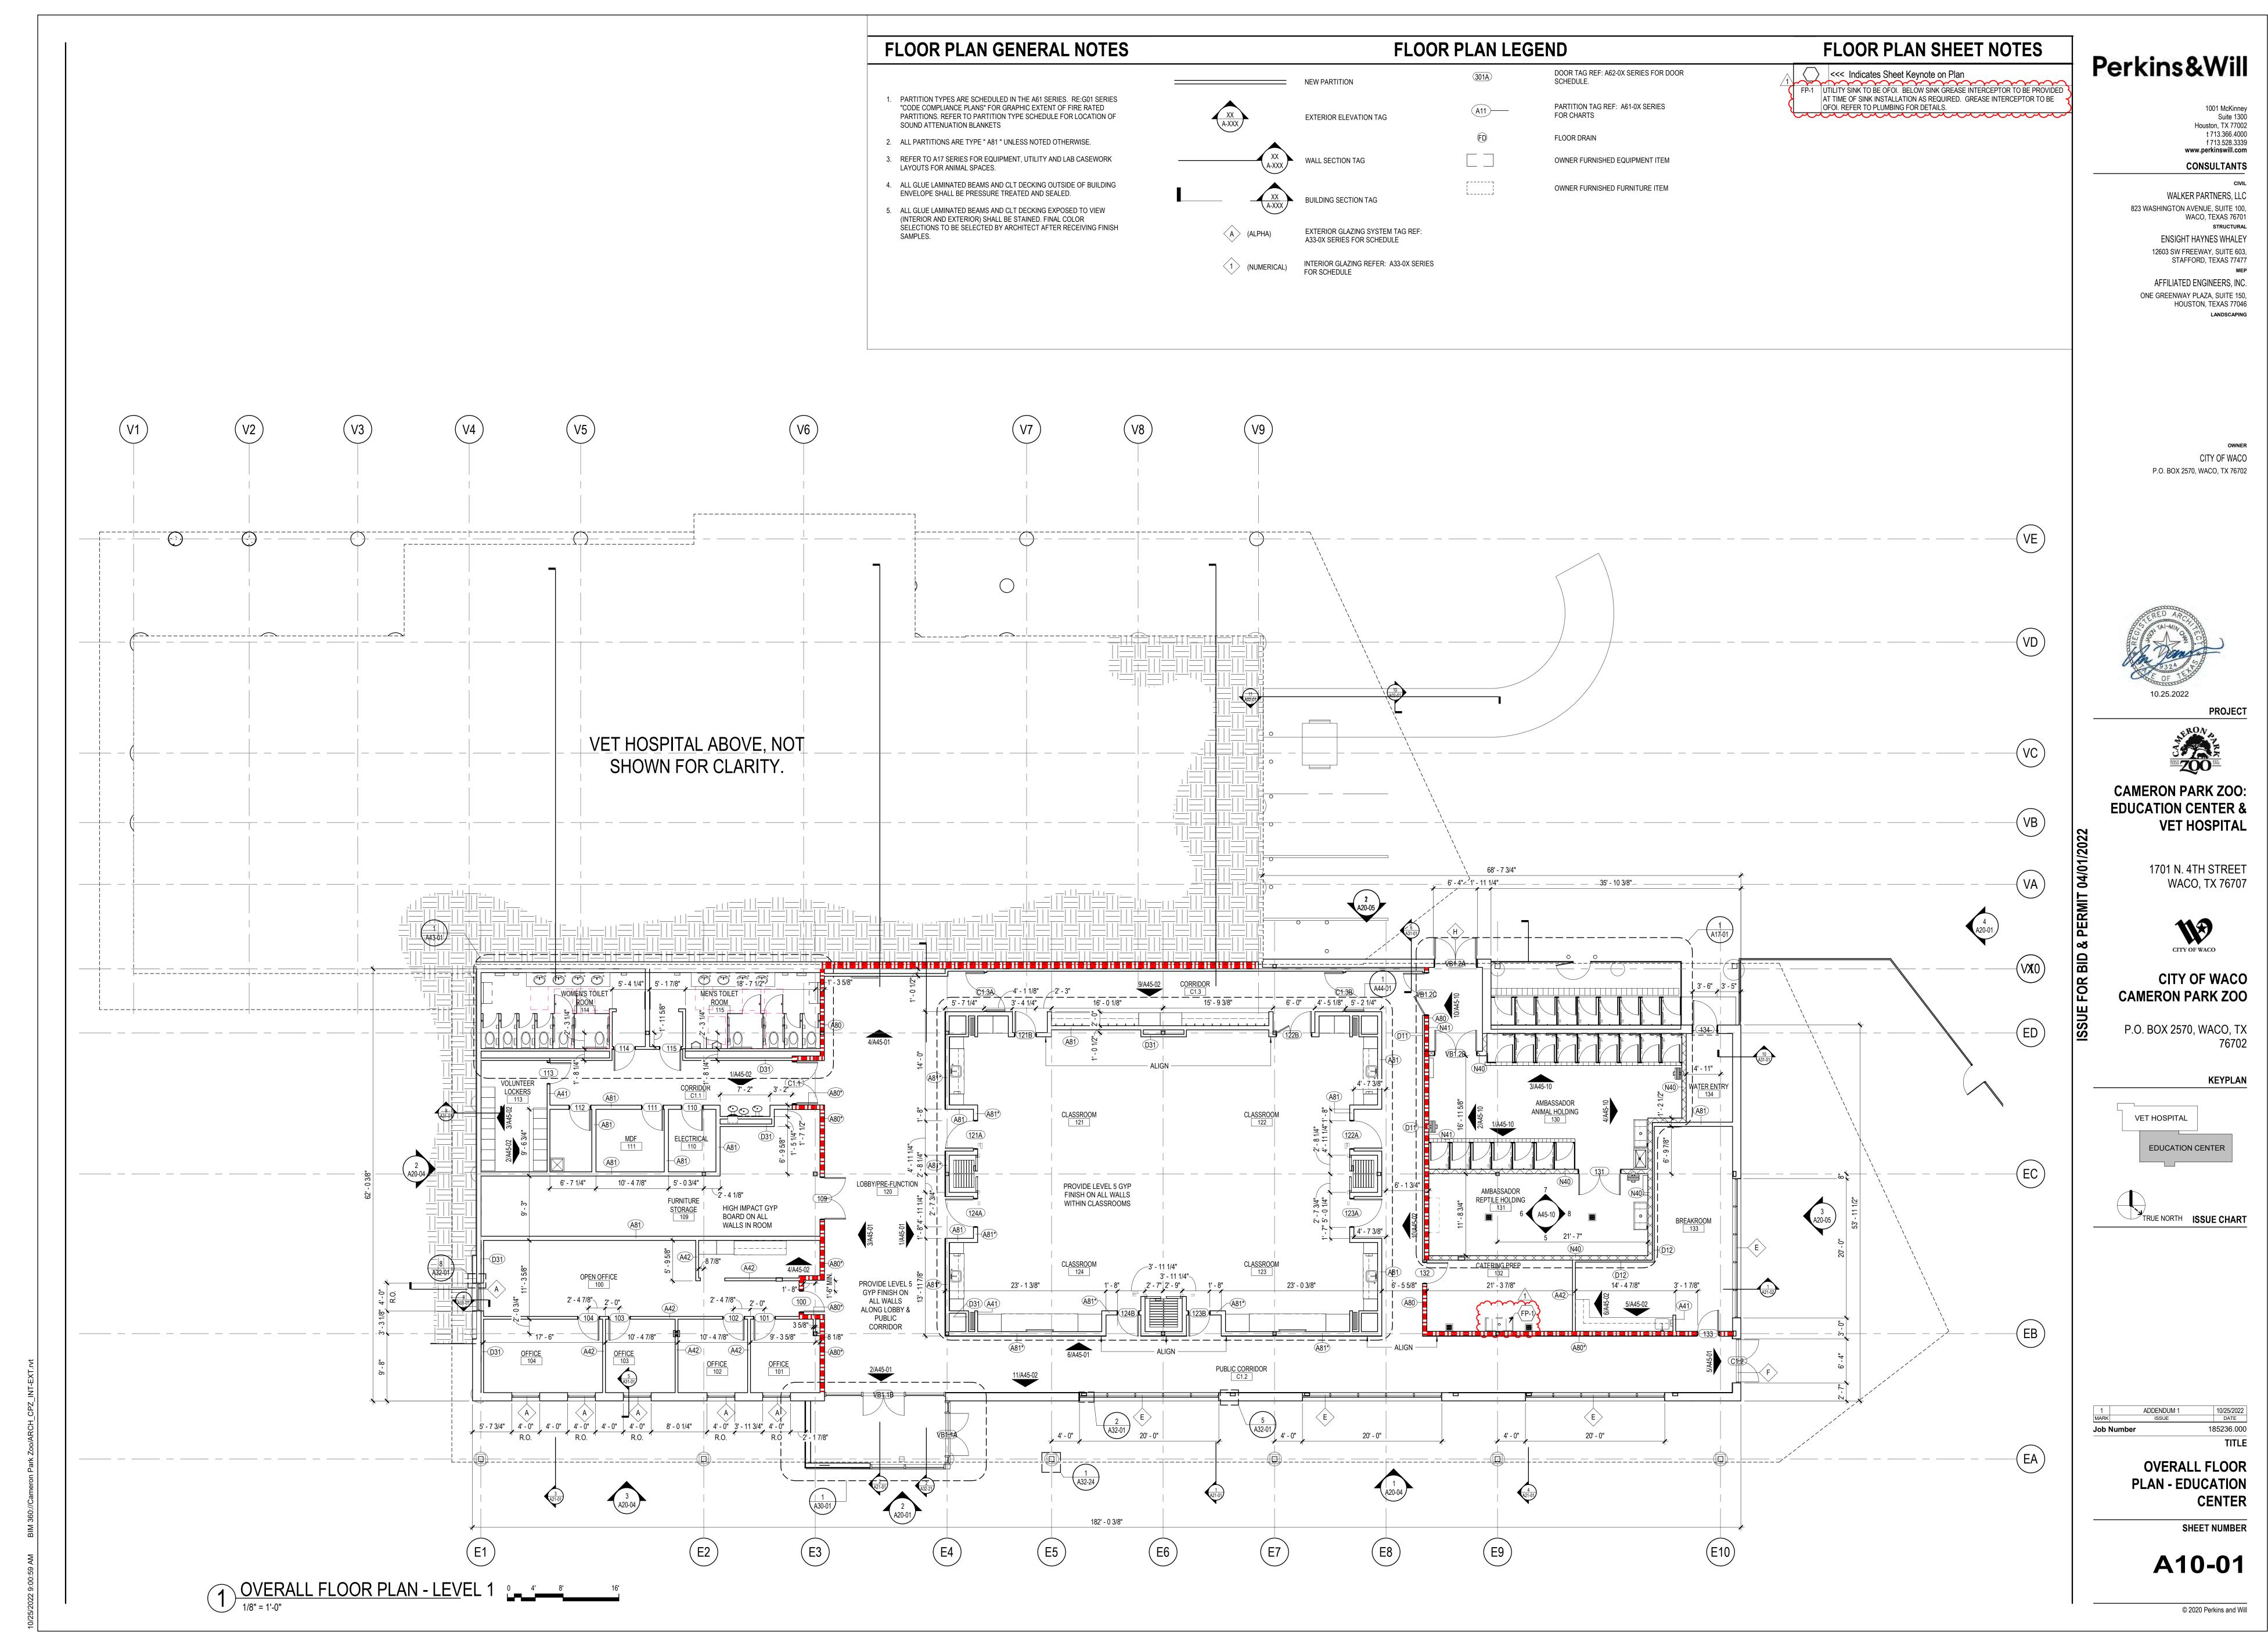

# **EQUIPMENT PLAN GENERAL NOTES**

DRAWINGS FOR ADDITIONAL REQUIREMENTS.

- 1. THE CONTRACTOR SHALL VERIFY AND COORDINATE CLEAR DIMENSIONS REQUIRED FOR OWNER FURNISHED EQUIPMENT THAT ARE LOCATED WITHIN
- OR ADJACENT TO BUILT-IN CABINETS. 2. UTILITIES SHOWN ON THESE PLANS ARE FOR DIMENSIONAL REFERENCE AND EQUIPMENT COORDINATION PURPOSES. REFER TO ELECTRICAL, PLUMBING

AND SECURITY DRAWINGS FOR DESIGN OF SYSTEM. NOT ALL RECEPTACLES

ARE SHOWN ON THESE DRAWINGS, REFER TO ELECTRICAL AND TELECOM

- 3. CONTRACTOR SHALL SUPPLY BLOCKING FOR MOUNTING OF EQUIPMENT UNLESS MOUNTING SUPPORT IS OTHERWISE FURNISHED AS PART OF THE
- 4. CONTRACTOR SHALL COORDINATE WITH THE OWNER ON THE DELIVERY AND
- INSTALLATION OF OWNER FURNISHED EQUIPMENT. 5. REFER TO A43 SERIES FOR MISCELLANEOUS EQUIPMENT MOUNTING
- 6. UTILITY ROUTING TO BE CONCEALED IN-WALL AND/OR ABOVE CEILING. EXPOSED CONDUIT NOT PERMITTED UNLESS NOTED OTHERWISE.

# **EQUIPMENT PLAN LEGEND**

OWNER FURNISHED EQUIPMENT DESIGNATION. REFER TO OWNER EQUIPMENT MANUAL FOR \_\_\_\_\_XXXXX SPECIFICATION. TOILET ACCESSORY TAG. REFER TO A43-01 FOR LEGEND. OWNER FURNISHED OWNER INSTALLED CASEWORK

——\_\_\_\_TA1

OWNER FURNISHED OWNER INSTALLED EQUIPMENT ITEM

ELECTRICAL RECEPTACLE, RE: ELECTRICAL DRAWINGS FOR ADDITIONAL REQUIREMENTS MOUNTING HEIGHT A.F.F.

**EQUIPMENT PLAN** 

**NOTES BY NUMBER** 

<>< Indicates Sheet Keynote on Plan



Perkins&Will

1001 McKinney

t 713.366.4000

f 713.528.3339

www.perkinswill.com

CONSULTANTS

WACO, TEXAS 76701

WALKER PARTNERS, LLC

ENSIGHT HAYNES WHALEY

12603 SW FREEWAY, SUITE 603, STAFFORD, TEXAS 77477

AFFILIATED ENGINEERS, INC. ONE GREENWAY PLAZA, SUITE 150,

HOUSTON, TEXAS 77046

CITY OF WACO

P.O. BOX 2570, WACO, TX 76702

823 WASHINGTON AVENUE, SUITE 100,

Suite 1300 Houston, TX 77002



**EDUCATION CENTER & VET HOSPITAL** 

> 1701 N. 4TH STREET WACO, TX 76707



**CITY OF WACO** 

**CAMERON PARK ZOO** P.O. BOX 2570, WACO, TX

**KEYPLAN** 


VET HOSPITAL **EDUCATION CENTER** 

TRUE NORTH ISSUE CHART

EQ, CASEWORK & UTILITY **COORDINATION PLAN** - ANIMAL

A17-01

© 2020 Perkins and Will

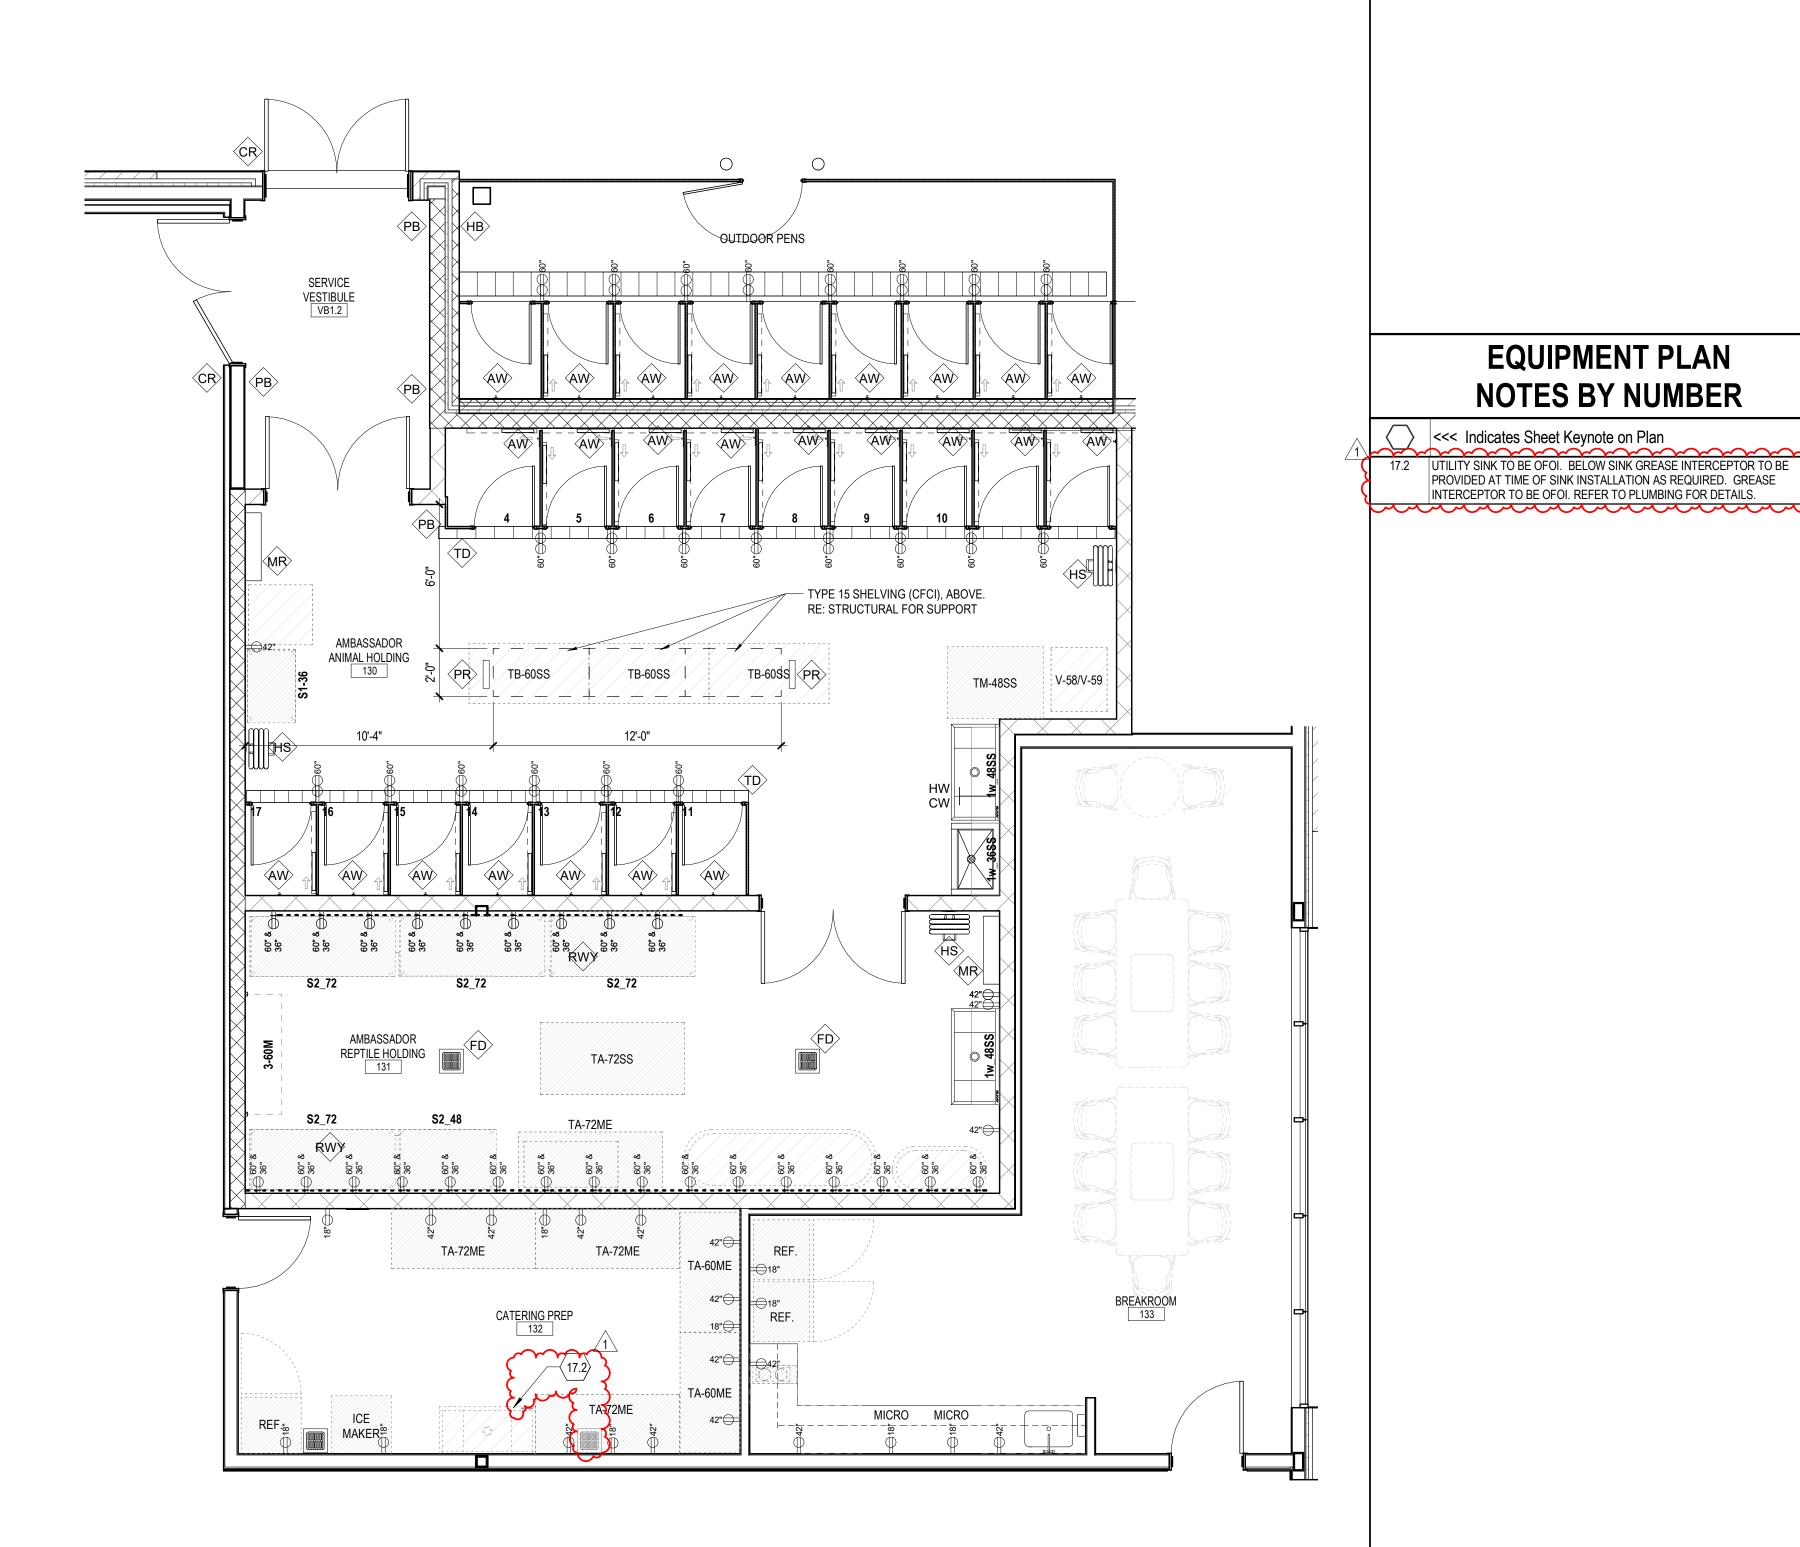

**EQUIPMENT & UTILITY COORDINATION PLAN - ED CENTER - EAST** 

RFP 2022-084 Cameron Park Zoo Education Center & Vet Hospital WHERE STRUCTURAL STEEL SHAPES ARE INDICATED ON ARCHITECTURAL OR **NOMINAL HOLE DIMENSIONS** STRUCTURAL DETAILS, AND/OR NO SIZE IS SHOWN EITHER ON PLAN OR ON THE (BASED ON AISC STEEL CONSTRUCTION MANUAL, 15TH DETAILS, USE THE FOLLOWING MEMBER WEIGHTS FOR BIDDING PURPOSES: STANDARD OVERSIZED SHORT-MISCELLANEOUS STEEL SCHEDULE DIAMETER HOLE HOLE HOLE DIAMETER SIZE DIAMETER SIZE (d) **ANGLES** 17 PLF 9/16" 5/8" 9/16" x 11/16" 5/8" 13/16" 11/16" LOOSE LINTELS 18 PLF 3/4" 13/16" 15/16" 13/16" 20.7 PLF CHANNELS 7/8" 15/16" 15/16" 1 1/16" WIDE FLANGE BEAMS 40 PLF 1 1/8" x 1 1/8" 1 1/4" WIDE FLANGE COLUMNS 75 PLF ≥1 1/8" d+5/16" (d+1/8") x d+1/8" HSS BEAMS 30 PLF HSS COLUMNS 30 PLF 1. THE DISTANCE BETWEEN CENTERS OF STANDARD, OVERSIZED, OR SLOTTED HOLES SHALL NOT BE LESS THAN (2 2/3) TIMES THE NOMINAL DIAMETER 'd' OF THE FASTENER. 30 PLF PIPE COLUMNS 2. THE CLEAR DISTANCE BETWEEN BOLT HOLES OR SLOTS SHALL NOT BE 155 LB BASE PLATES LESS THAN 'd'. **NOTE:** THE GENERAL CONTRACTOR SHALL VERIFY AND CONFIRM ACTUAL MEMBER SIZES WITH THE PROJECT ARCHITECT AND ENGINEER PRIOR TO FABRICATION. LESS THAN 1/16" PROVIDED THE WELD IS CLEARLY VERIFIABLE. 22 STANDARD MISCELLANEOUS STEEL SCHEDULE - WEIGHT SCALE: NOT TO SCALE STANDARD BOLTED CONNECTION REQUIREMENTS
SCALE: NOT TO SCALE / L 4"x4"x1/2"x0'-10" PL 1/4"x6"x0'-6" , L3-1/2x3-1/2x3/8 x 0'-8" W/ (3) - 5/8"Ø x 0'-6" LONG W/ (1) 1/2"Ø x 0'-4" LONG W/ (3) 5/8"Ø x 0'-6" LONG HEADED STUD ANCHOR HEADED STUD ANCHOR HEADED STUD ANCHORS 1 1/2" PLATE 'A' PLATE 'B' ANGLE 'C' - L6x4x3/8 X 1'-6" W/ (3) 1/2"Ø X 1'-6" D.B.A. -1 1/2" / PL 3/8"x8"x0'-8" W/ (4) 1/2"Ø x 0'-4" LONG HEÀDED STUD ANCHORS L6x6x3/8x1'-0" W/ (4) 1/2"Ø x 1'-0" LONG DEFORMED BAR ANCHORS 1'-6" ANGLE 'J' PLATE 'H' ANGLE 'G' NOTE: REFER TO ARCHITECT FOR LOCATIONS CL OF HSS PL 3/4"x12"x1'-8" W/ (6) 3/4"Ø x 0'-5" LONG HEÀDED STUD ANCHORS - PL 1/2"x12"x1'-0" W/ (4) 1/2"Ø x 0'-4" LONG RE: ARCHITECT HEADED STUD ANCHORS (3'-6" MAX) - CONTINUOUS 3x3x1/4 BETWEEN HSS BEAMS - HSS 4x4x5/16 @ 3'-0" MAX, O.C. PLATE 'N' PLATE 'P' - HSS 4x4x5/16 VERTICAL LOCATED WITHIN WALL - 1/2"x9"x0'-9" PLATE W/ (4) 1/2" DIAMETERx0'-6" LONG HEADED STUDS COUNTERTOP LAVATORY SUPPORT
SCALE: NOT TO SCALE STANDARD AISC DOUBLE ANGLE CONNECTION SUPPORTING STANDARD AISC DOUBLE ANGLE CONNECTION MEMBER THIS CONNECTION SHALL ONLY BE USED WHERE SPECIFICALLY NOTED OR ALLOWED ON THE STRUCTURAL DOCUMENTS. 1. DESIGN CHECKS SHALL INCLUDE: BOLT GROUP REQUIRED FOR BOLT SHEAR AND BOLT BEARING WITH MAXIMUM PLATE THICKNESS. PLATE LIMIT STATES OF SHEAR YIELDING, SHEAR RUPTURE, AND MIN WEB THICKNESS BLOCK SHEAR RUPTURE. PROVIDE CONNECTION SEAT OR OTHER PROVIDE CONNECTION SEAT OR OTHER PLATE LIMIT STATES OF SHEAR YIELDING SHEAR BUCKLING AND APPROVED METHOD AS REQUIRED TO APPROVED METHOD AS REQUIRED TO YIELDING DUE TO FLEXURE. COMPLY WITH O.S.H.A. REQUIREMENTS. COMPLY WITH O.S.H.A. REQUIREMENTS. PLATE LIMIT STATE OF BUCKLING. SUPPORTED BEAM BRACING.

<sup>5TH</sup> EDITION,	TABLE J3.3)	MINIMUM FILLET WE (BASED ON AISC STEEL CONSTRUCTION MAI	-
-SLOTTED LE SIZE	LONG-SLOTTED HOLE SIZE	MATERIAL THICKNESS OF THINNER PART JOINED (INCHES)	MINIMUM SIZE OF FILLET WELD (INCHES)
x 11/16"	9/16" x 1 1/4"	TO 1/4" INCLUSIVE	3/16"
6" x 7/8"	11/16" x 1 9/16"	OVER 1/4" TO 1/2"	3/16"
16" x 1"	13/16" x 1 7/8"	OVER 1/2" TO 3/4"	1/4"
5" x 1 1/8"	15/16" x 2 3/16"	OVER 3/4"	5/16"
' x 1 5/16"	1 1/8" x 2 1/2"		
) x (d+3/8")	(d+1/8") x (2.5xd)"		

1. UNLESS NOTED OTHERWISE, ALL WELDED PARTS SHALL BE WELDED ALL AROUND, ALL ACCESSIBLE SIDES.

- 2. THE MINIMUM SIZE OF FILLET WELD SHALL NOT BE LESS THAN THE SIZE REQUIRED TO TRANSMIT CALCULATED FORCES, NOR THE SIZE SHOWN ABOVE. THESE REVISIONS DO NOT APPLY TO FILLET WELD REINFORCEMENTS OF PJP ( CJP GROOVE WELDS.
- 3. THE MAXIMUM SIZE OF FILLET WELDS OF CONNECTED PARTS SHALL BE: A. ALONG EDGES OF MATERIAL LESS THAN 1/4" THICK; NOT GREATER THAN TH THICKNESS OF MATERIAL. B. ALONG EDGES OF MATERIAL 1/4" OR MORE IN THICKNESS; NOT GREATER THAT THE THICKNESS OF THE MATERIAL MINUS 1/16", UNLESS NOTED OTHERWISE, IN THE AS-WELDED CONDITION, THE DISTANCE BETWEEN THE EDGE OF THE BASE METAL AND THE TOE OF THE WELD IS PERMITTED TO BE

2 1/2"

(1) #4 X 2'-6"

PLATE 'Q'

— PL 3/4"x12"x2'-4"

W/ (8) 3/4"Ø x 0'-7" LONG

HEÀDED STUD ANCHORS

PL 3/8"x6"x1'-0"

W/ (2) 1/2"Ø X

0'-4" LONG HEADED STUD ANCHORS

- L6x4x3/8 X 1'-0" W/ (3) 1/2"Ø X

1'-6" D.B.A. & (2) 1/2"Ø X 0'-4"

LONG HEADED STUD ANCHOR

(1) #4 X 2'-6"

PLATE 'R'

SUPPORTING MEMBER

MIN WEB

(NOTE 5)

THICKNESS

≺THICKNESS OF PLATE (IN)

GROUP A OR GROUP B BOLTS <= 1"

(LOOSE)

PLATE 'D'

2" 4" 4" 2"

ANGLE 'K'

	MASONRY OPENING	<u>SIZE</u>	DETAIL
	LESS THAN 4'-0"	L 8 x 4 x 1/2" (LLH)	
	4'-0" BUT LESS THAN 5'-0"	L 8 x 4 x 1/2" (LLH)	
	5'-0" BUT LESS THAN 6'-0"	L 8 x 4 x 1/2" (LLH)	
	6'-0" BUT LESS THAN 7'-0"	L 8 x 4 x 1/2" (LLH)	
	7'-0" BUT LESS THAN 8'-0"	L 8 x 4 x 1/2" (LLH)	
E. OR	8'-0" BUT LESS THAN 10'-0"	L 8 x 4 x 1/2" (LLH)	
THE	10'-0" AND UP TO 20'-0"	WT12x31	

PROVIDE 8" MINIMUM BEARING EACH END FOR STEEL LOOSE LINTELS. ONE ANGLE SHALL BE PROVIDED FOR EACH WYTHE OF BRICK. SEE ARCHITECTURAL DRAWINGS FOR LOCATION. EXTERIOR LINTELS SHALL BE HOT DIPPED LOOSE LINTELS SHALL NOT BE USED FOR ANCHORAGE OR SUPPORT OF

WINDOWS, WALL SYSTEMS, OR OTHER MEASURES.

**NOTE:** MINIMUM DISTANCE FROM EDGE

OF PLATE TO EDGE OF CONCRETE:

PL 1/2"x10"x0'-10"

PLATE 'M'

·── ◆├<del>⊫</del>──<del>ऻ</del>

PLATE 'S'

- PL 3/4"x12"x12" WITH

(4) - 3/4"Ø x 0'-8" LONG **HEADED STUDS** 

W/ (4) 1/2"Ø x 0'-4" LONG HEÀDED STUD ANCHORS

• 1" TOP AND SIDES

4-1/4" BOTTOM

- L 6"x4"x1/2"x1'-2" W/(2) 3/4"Ø PLATE 'F'

x 6" LONG HEADED STUDS

AND (2) - 1/2"Ø x 1'-0" LONG DEFORMED BAR ANCHORS

—— PL 3/4"x10"x1'-4"

NOTE: MINIMUM DISTANCE FROM EDGE OF PLATE TO EDGE OF CONCRETE:

ANGLE 'L'

/ GALV. PL 1/2"x19"x2'-3"

LONG HEADED STUDS

W/(12) - 3/4"Ø x 0'-6"

1" TOP AND SIDES

4-1/4" BOTTOM

W/ (6) 1/2"Ø x 0'-4" LONG

HEADED STUD ANCHORS

- PL 1"x12"x1'-10" W/ (8) 1/2"Ø x 0'-4" LONG CITY OF WACO HEADED STUD ANCHORS P.O. BOX 2570, WACO, TX 76702



Perkins&Will

1001 McKinney

t 713.366.4000 f 713.528.3339

www.perkinswill.com

CONSULTANTS

WACO, TEXAS 76701

WALKER PARTNERS, LLC

ENSIGHT HAYNES WHALEY

STAFFORD, TEXAS 77477

HOUSTON, TEXAS 77046

12603 SW FREEWAY, SUITE 603,

AFFILIATED ENGINEERS, INC.

ONE GREENWAY PLAZA, SUITE 150,

823 WASHINGTON AVENUE, SUITE 100.

Suite 1300 Houston, TX 77002

**PROJECT** 



**VET HOSPITAL** 

1701 N. 4TH STREET WACO, TX 76707



**CITY OF WACO CAMERON PARK ZOO** 

P.O. BOX 2570, WACO, TX

**KEYPLAN** VET HOSPITAL **EDUCATION CENTER** 



ADDENDUM 1 185236.000 Job Number

> STANDARD STEEL **DETAILS**

> > SHEET NUMBER

TITLE

**S60-10** 

© 2022-ENSIGHT HAYNES WHALEY, LLC

5 ROWS W27 & W30 W33, W36, W40 7 ROWS

1. CONNECTION DESIGN SHALL BE IN ACCORDANCE WITH AISC-MANUAL OF STEEL CONSTRUCTION PART 10, TABLE 10-10 FOR CONVENTIONAL CONFIGURATION ONLY. 2. REFER TO AISC-MANUAL OF STEEL CONSTRUCTION (PART 1) 3. ONLY A SINGLE ROW OF BOLTS IS PERMITTED. THE NUMBER OF BOLTS IN CONNECTION, N, MUST BE BETWEEN 2 AND 12.

**CONVENTIONAL CONFIGURATION** 

3 1/2"\_\_\_2x BOLT DIA (MIN)

4. HOLES IN PLATE MAY BE STANDARD HOLES (STD) OR SHORT-SLOTTED HOLES (SSLT) TRANSVERSE TO THE DIRECTION OF THE SUPPORTED MEMBER. 5. EITHER PLATE THICKNESS OR BEAM WEB THICKNESS MUST SATISFY THE MAXIMUM THICKNESS REQUIREMENT OF AISC-MANUAL OF STEEL CONSTRUCTION TABLE 10-9. . THE SUPPORTING MEMBER. BOLTS. AND PLATE CAPACITY OF BOLTED CONNECTIONS SHALL BE DETERMINED FROM AISC-MANUAL OF STEEL CONSTRUCTION PART 7. BOLTS AND PLATE MUST BE CHECKED FOR REQUIRED SHEAR WITH AN ECCENTRICITY PER AISC-MANUAL OF STEEL CONSTRUCTION TABLE 10-9.

7. FOR COPED BEAM CONNECTIONS. THE CAPACITY OF THE NET SHEAR AREA OF THE WEB SHALL BE VERIFIED. 8. THE CAPACITY OF THE CONNECTION SHALL BE THE LESSER VALUE OF THE ALLOWABLE BOLT CAPACITY, ALLOWABLE WELD CAPACITY, SUPPORTING PLATE CAPACITY OR THE WEB NET SHEAR CAPACITY.

9. THE MINIMUM NUMBER OF ROWS OF BOLTS SHALL BE AS FOLLOWS: W8, W10, & W12
 2 ROWS 3 ROWS W14 & W16

W18, W21, & W24
 4 ROWS

STANDARD AISC SINGLE SHEAR PLATE CONNECTION DETAIL - CONVENTIONAL CONFIGURATION

WHERE CONVENTIONAL CONFIGURATION SINGLE SHEAR PLATES ARE NOT FEASIBLE, EXTENDED CONFIGURATIONS MAY BE USED WHERE CONNECTION DESIGN ECCENTRICITY IS LESS THAN 2 1/2" OR EXTENDED CONFIGURATION IS SPECIFICALLY NOTED OR DETAILED IN THE STRUCTURAL DRAWINGS. FULL DEPTH SHEAR PLATES SHALL NOT BE USED UNLESS SPECIFICALLY NOTED OR DETAILED IN THE STRUCTURAL DRAWINGS.

SCALE: NOT TO SCALE

SHEAR PLATE

**CONNECTION NOTES:** 

STANDARD CONVENTIONAL OR

FOR ADDITIONAL INFORMATION.

EXTENDED AISC SINGLE SHEAR PLATE

CONNECTION. SEE CONNECTION NOTES

REFER TO AISC-MANUAL OF STEEL CONSTRUCTION (PART 1)

4 ROWS

5 ROWS

6 ROWS

6. THE MINIMUM NUMBER OF ROWS OF BOLTS SHALL BE AS FOLLOWS:

THE WEB NET SHEAR CAPACITY.

• W8, W10, & W12 2 ROWS

W14 & W16

W27 & W30

W33 & W36

W18, W21, & W24

GROUP A OR GROUP B BOLTS <= 1"

1. CONNECTION DESIGN SHALL BE IN ACCORDANCE WITH AISC-MANUAL OF STEEL CONSTRUCTION PART 10, EXTENDED CONFIGURATION.

THE SUPPORTING MEMBER CAPACITY OF BOLTED CONNECTIONS SHALL BE DETERMINED FROM AISC-MANUAL OF STEEL CONSTRUCTION PART 7.

5. THE CAPACITY OF THE CONNECTION SHALL BE THE LESSER VALUE OF THE ALLOWABLE BOLT CAPACITY, ALLOWABLE WELD CAPACITY, SUPPORTING PLATE CAPACITY OR

**EXTENDED CONFIGURATION** 

4. FOR COPED BEAM CONNECTIONS, THE CAPACITY OF THE NET SHEAR AREA OF THE WEB SHALL BE VERIFIED.

STANDARD AISC SINGLE PLATE CONNECTION DETAIL - EXTENDED CONFIGURATION

FULL DEPTH STABILIZER PLATES AS

REQUIRED BY DESIGN

EXTENDED CONFIGURATION

STANDARD SINGLE SHEAR PLATE OR

DOUBLE ANGLE CONNECTION

STANDARD BEAM TO WIDE FLANGE COLUMN CONNECTION DETAIL


SINGLE SHEAR PLATE


AT WEB

**AT FLANGE** 

26 of 30

REQUIREMENT FOR STABILIZER PLATES.

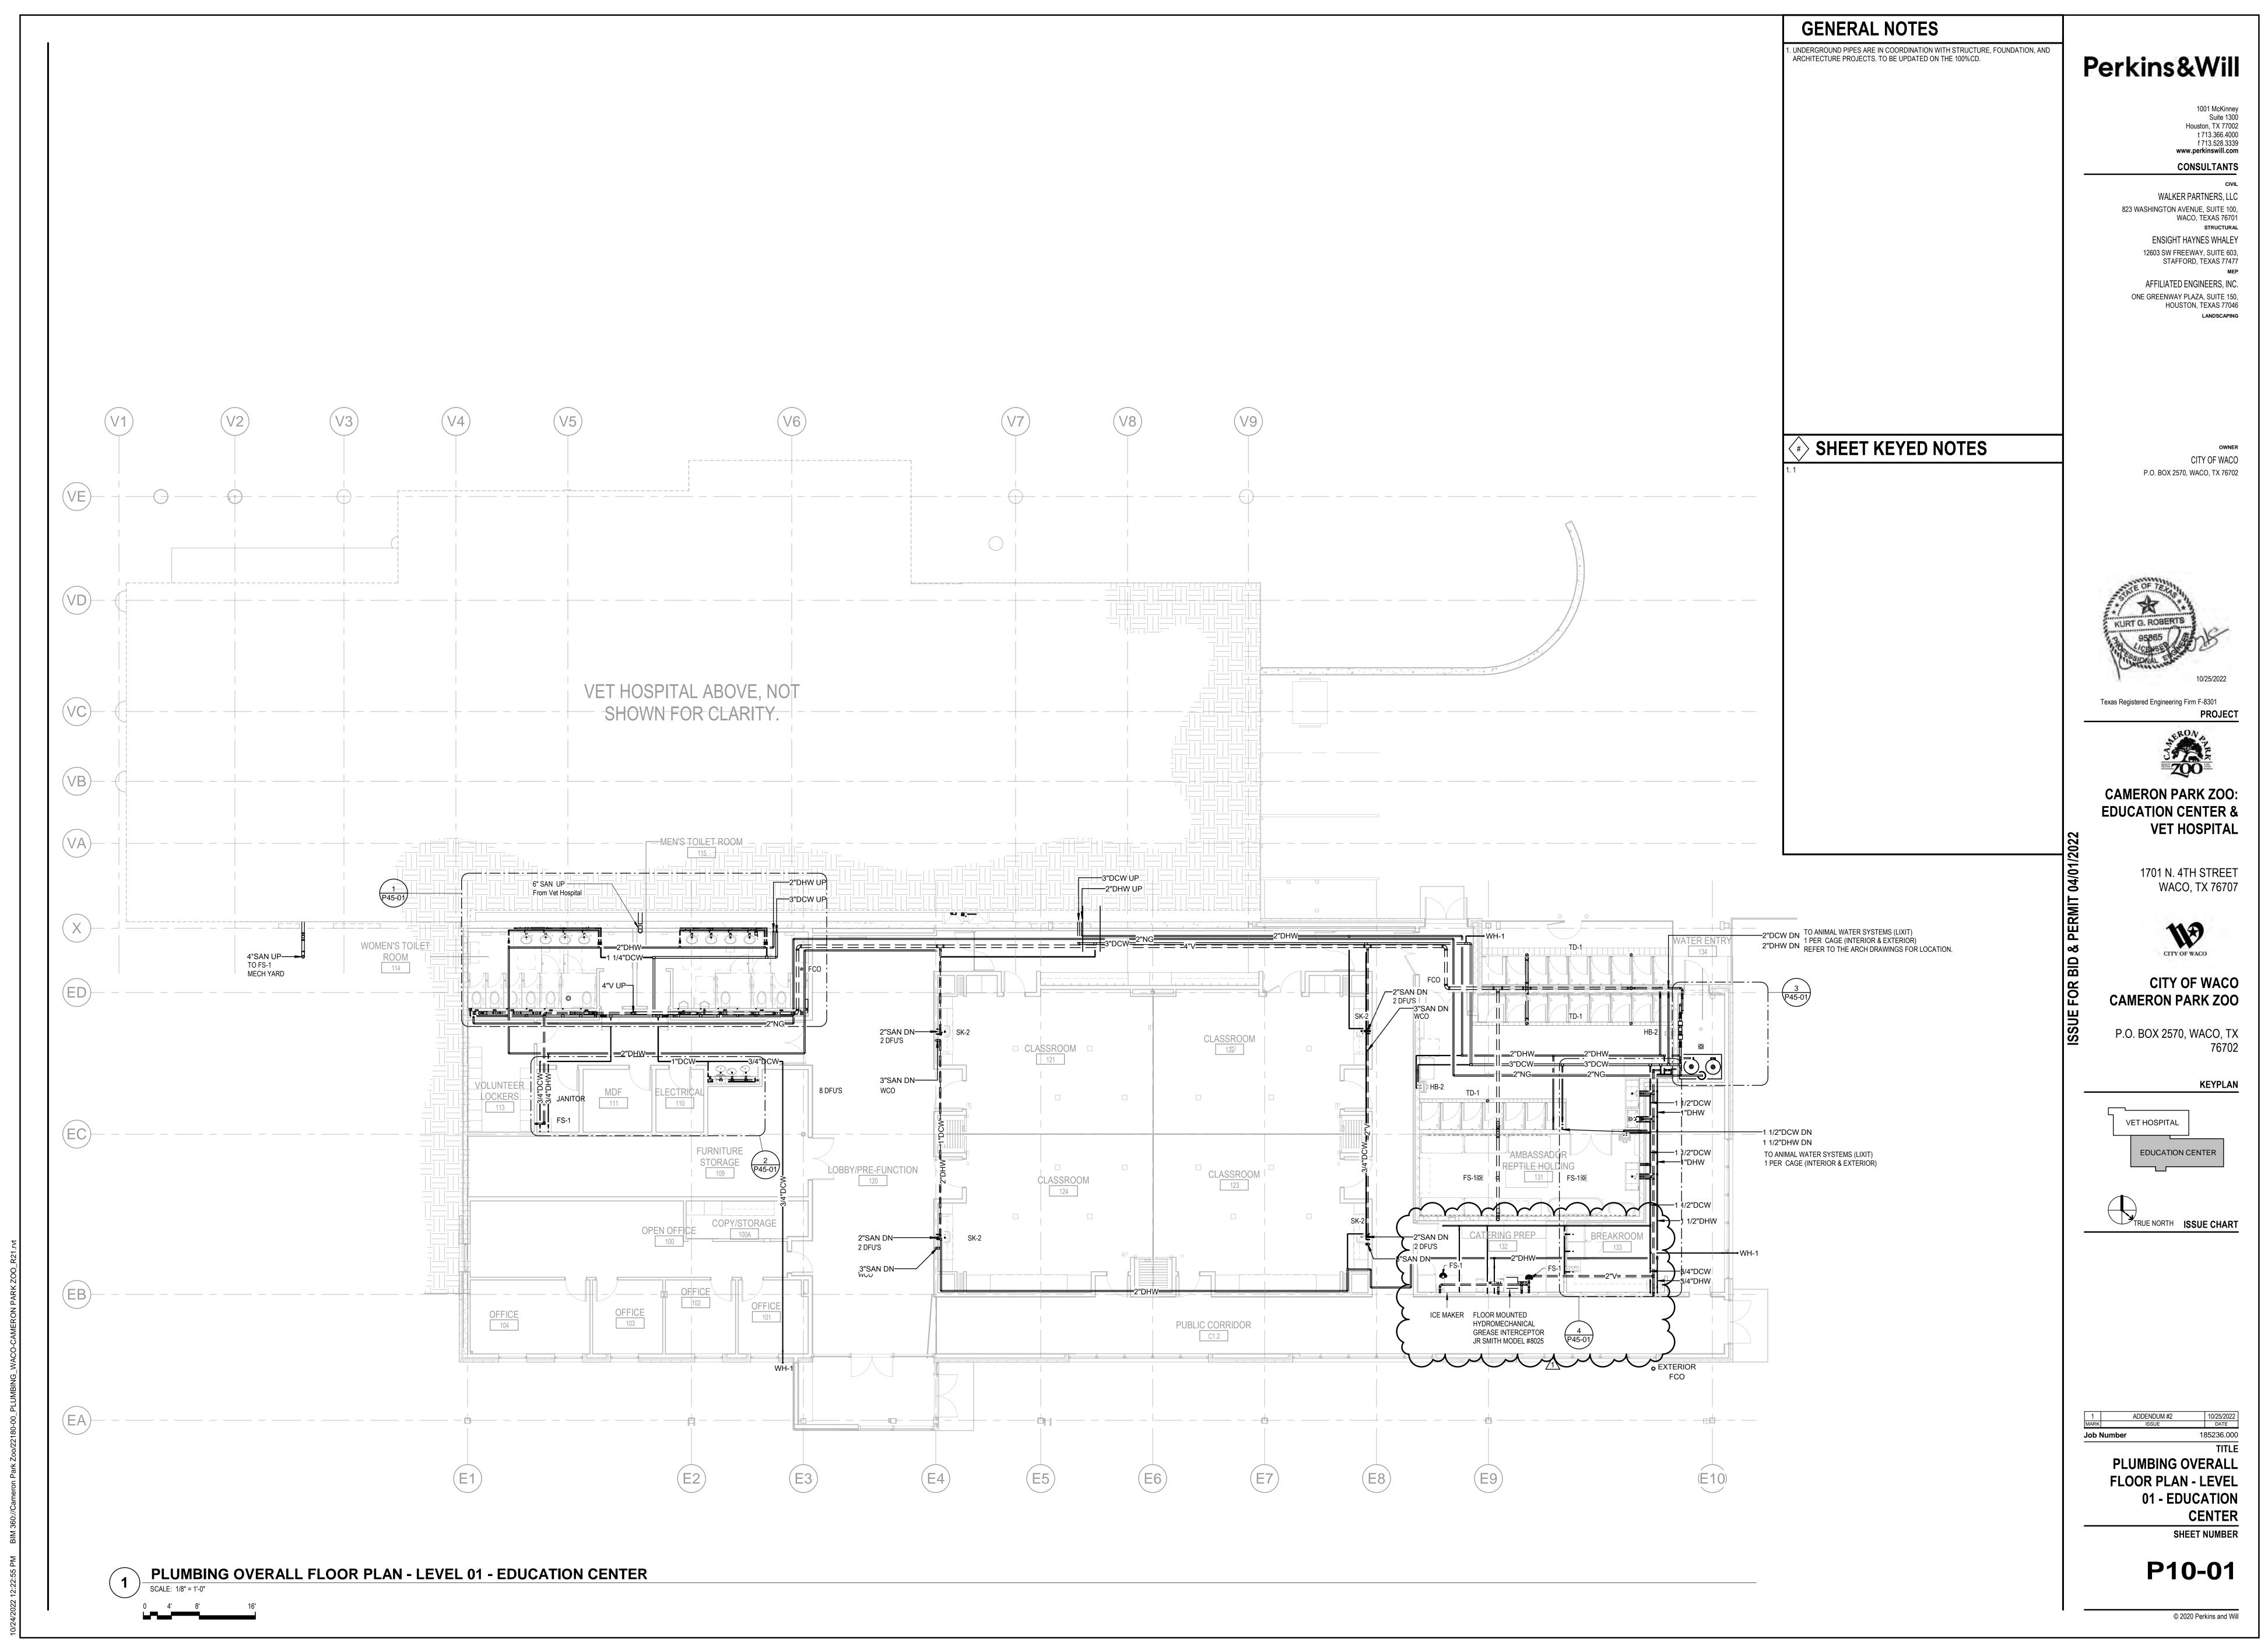

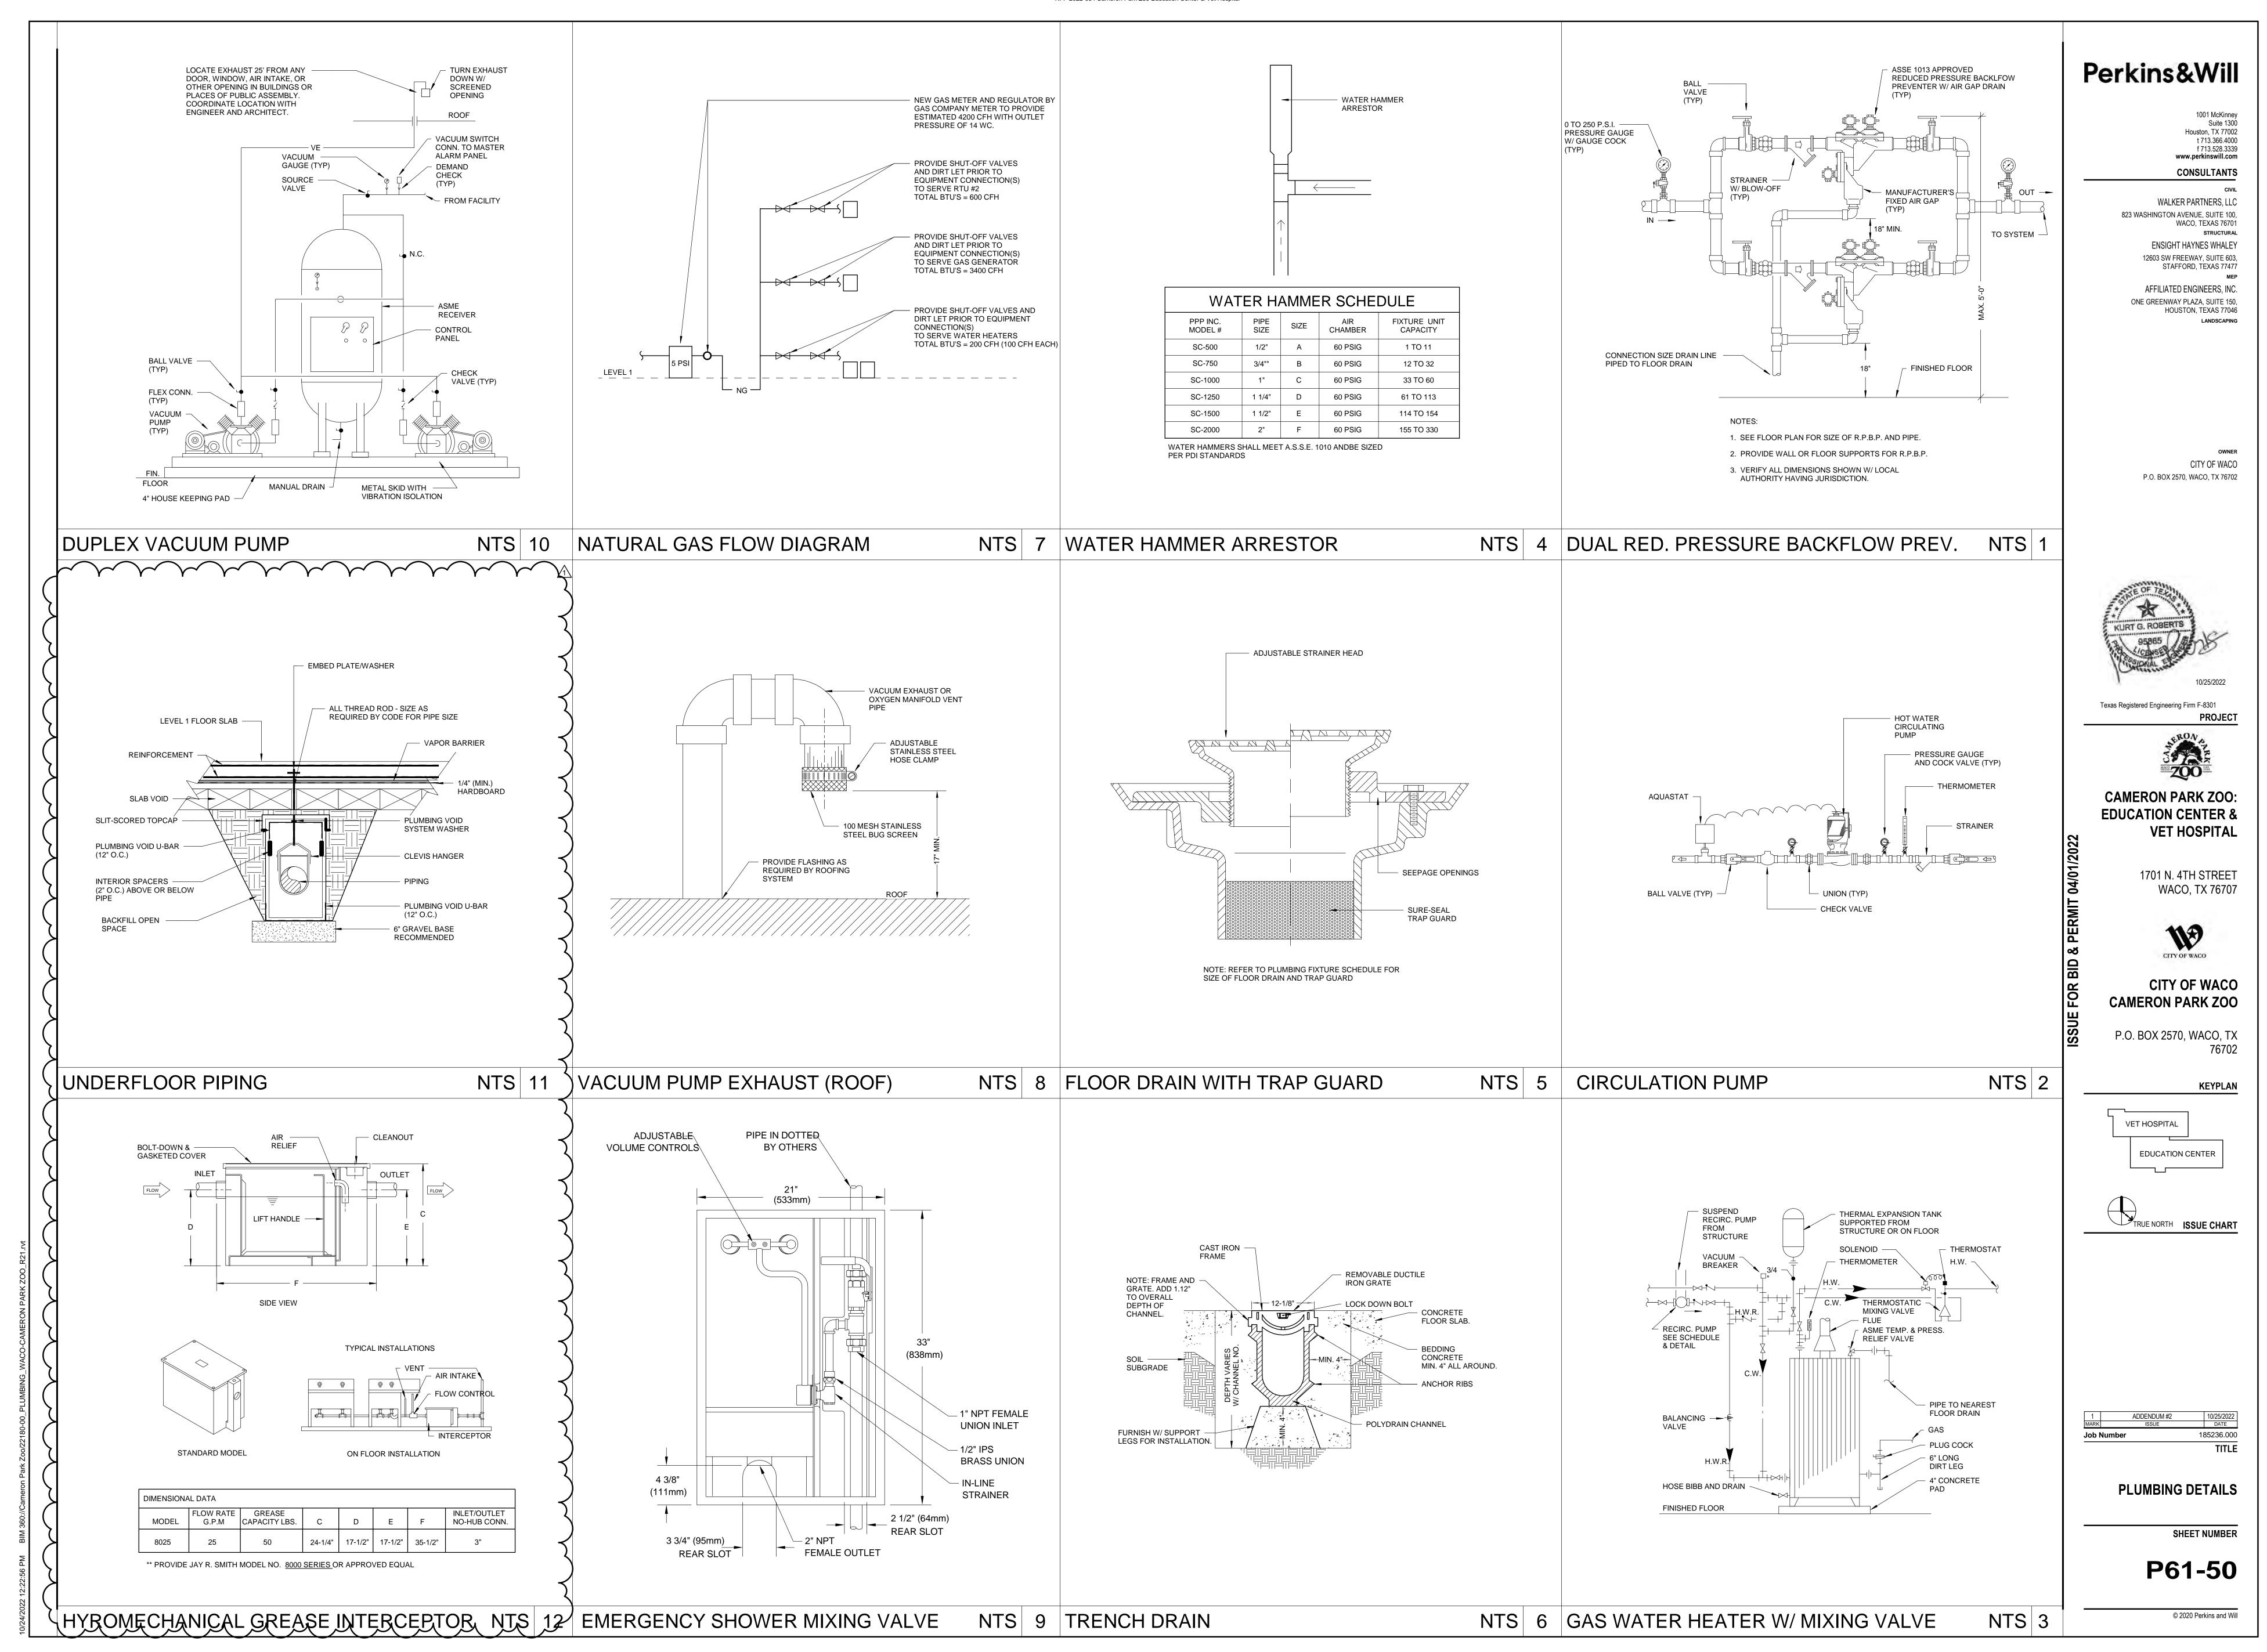

RFP 2022-084 Cameron Park Zoo Education Center & Vet Hospital

**GENERAL NOTES:** 

1. SEE SPECIFICATIONS FOR ADDITIONAL REQUIREMENTS AND ACCESSORIES.

3. PROVIDE 3" CONCENTRIC VENT, ACID NEUTRALIZATION KIT, LOW PROFILE CAP.

2. PROVIDE 4" THICK REINFORCED CONCRETE PAD BELOW ALL FLOOR MOUNTED EQUIPMENT.

CERTIFICATION AGENCY AND IN ACCORDANCE WITH THE REQUIREMENTS OF THE NEC.

**GENERAL NOTES:** 

1. REFER TO DRAWINGS FOR INLET AND OUTLET INVERT

4. PLUMBING EQUIPMENT SHALL BE LISTED, LABELED, AND MARKED FOR USE BY AN APPROVED THIRD-PARTY

PLUMBING FIXTURE SCHEDULES

### **GENERAL NOTES:**

1. BRANCH CONNECTION SIZES ARE INDICATED. REFER TO FLOOR PLANS FOR MAIN PIPING SIZES.

2. REFER TO ARCHITECTURAL DRAWINGS FOR LOCATIONS AND MOUNTED ELEVATIONS. 3. INSTALL ALL FIXTURES AND ACCESSORIES APPLICABLE CODES AND/OR MANUFACTURER RECOMMENDATIONS. 4. PROVIDE POWER AND COORDINATE ALL ELECTRICAL CONNECTIONS AS REQUIRED FOR COMPLETE WORKING INSTALLATION.

DP-1 DRINKING ECHNYTAN 1 S. Hydrocous Both Eight Station & Integral OVL II Fourish Filtered 8 gph Starlines . 1-12 Audition High Station & Integral OVL II Fourish Filtered 8 gph Starlines . 1-12 Audition Street Administration (Mail Montald).  DP-2 DRINKING FOURISH . 1-12 Audition Street Administration (Mail Montald).  DP-3 Audition Street ELKAY 3. 3. ELKAY EZPLOS Batter Bling Station with Single ADA Garcer, Filtered Refrigerated Light Gray, 8GPH 4. Touchiese Semon-Administration (Mail Montald).  EW-1 PER-ADE WASH SPRAY HEAD ASSEMBLY (Wall Mounted).  EW-1 PER-ADE WASH SPRAY HEAD ASSEMBLY (Wall Mounted).  LV-1 Landony Chuller R (2000). 2. Facel RADIA FV KAPP HEAD ASSEMBLY . 3. ELEVERACE WASH SPRAY HEAD ASSEMBLY . 4. AND Complishose .  LV-2 Landony Chuller R (2000). 2. Facel RADIA FV KAPP FAULET METRO SERIES SS 3300. 4. BRATTERY STANDARD SENSOR  LV-2 Landony Chuller R (2000). 4. BRATTERY STANDARD SENSOR . 5. Facel ELKAY CHURTH MOUNTED . 1. Landony ELKAY STANDARD SENSOR . 4. BRATTERY STANDARD SENSOR . 5. Facel ELKAY CHURTH FAULET WITH EXPOSED DECK LAVATORY FAUCET INTEGRAL SPOUT SINGLE CONTROL 4* WITH STRUCK CHURTH SERIES STANDARD SENSOR . 5. Facel ELKAY CHURTH FAULET WITH EXPOSED DECK LAVATORY FAUCET INTEGRAL SPOUT SINGLE CONTROL 4* WITH STRUCK CHURTH SERIES STEEL 20* X 11-12* X 10-12* WALL HUNG SINGLE BOWL HAND WASH SINK EWSSEMPC . 5. Facel ELKAY CHURTH FAULE STANDARD CISSES STANDARD CISSES STEEL HOSE . 5. Facel ELKAY CHURTH FAULE STANDARD CISSES STEEL BASIN WI		2"	2"
1. Manufacture: ELKAY 2. Model: LZSSWSMS-Ring Station with Single ADA Croter, Filtered Refrigerated Light Gray, 8GPH 4. Touches Station Advanced 1.154/90Hz (Wall Mounted). 5. Touches Station Station Advanced 1.154/90Hz (Wall Mounted). 6. Touches Station with Drain Pan; Wall Mounted Exposed Shower Head 4. ADA Complained 2. Model: GREPTOT 3. Recessed Station with Drain Pan; Wall Mounted Exposed Shower Head 4. ADA Complained 4. ADA Complained 5. Recessed Station with Drain Pan; Wall Mounted Exposed Shower Head 4. ADA Complained 6. ADA Complained 6. ADA Complained 7. Page 1. Lavaron; KOHLER K-8000 7. Page 2. Page 1. Lavaron; KOHLER K-8000 7. Page 3. Page 3. Page 3. Page 4. ADA COLOR STATION STATIO			
1. Manufacturer Guardian 2. Model: GBF270 3. Recessed Sately Station with Drain Pan, Wall Mounted Exposed Shower Head 4. ADA Compliance 1. Levidory, KOHLER K 20000 3. Recessed Sately Station with Drain Pan, Wall Mounted Exposed Shower Head 4. BATTORY COUNTER MOUNTED 1. Levatory, KOHLER K 20000 3. Flow 1. Did gap 4. BATTERY STANDARD SENSOR 1. ADATTERY YALL MOUNTED 1. Levatory, ENDY STANDARD SENSOR 1. Paucet: ELKAY COMMERCIAL SENSOR SCRUBHANDWASH BATTERY POWERED DECK MOUNT FAUCET CHROME LKB721C 3. Flow 1. Did gap 1. Levatory, KOHLER K 20000 2. Faucet: ELKAY COMMERCIAL SENSOR SCRUBHANDWASH BATTERY POWERED DECK MOUNT FAUCET CHROME LKB721C 3. Flow 1. Did gap 1. Levatory, KOHLER K 20000 2. Faucet: ELKAY CENTERSET WITH EXPOSED DECK LAVATORY FAUCET INTEGRAL SPOUT SINGLE CONTROL 4" WRISTRIADGE HANDIE CHROME 3. Flow 2. Did gap 1. Levatory, KOHLER K 20000 2. Faucet: ELKAY CENTERSET WITH EXPOSED DECK LAVATORY FAUCET INTEGRAL SPOUT SINGLE CONTROL 4" 2. Faucet: ELKAY STANLESS STEEL 25 X 19-1/2" X 10-1/2" WALL HUNG SINGLE BOWL HAND WASH SINK EWS250FC 3. Flow 1. Did gap 1. Levatory, AMERICAN STANDARD - 0321.026 2. Faucet: ELKAY COMMERCIAL SENSOR SCRUBHANDWASH BATTERY POWERED DECK MOUNT FAUCET CHROME LKB721C 3. Flow 1. Did gap 1. Levatory, AMERICAN STANDARD - 0321.026 2. Faucet: ELKAY COMMERCIAL SENSOR SCRUBHANDWASH BATTERY POWERED DECK MOUNT FAUCET CHROME LKB721C 3. Flow 1. Did gap 4. Power Commercial Sensor Scrubhandwash BATTERY POWERED DECK MOUNT FAUCET CHROME LKB721C 3. Flow 1. Did gap 4. Power Commercial Sensor Scrubhandwash BATTERY POWERED DECK MOUNT FAUCET CHROME LKB721C 3. Flow 1. Did gap 5. Flow 1. Did gap 6. Flow 1. Did gap 6. Flow 1. Did gap 7.		2"	2"
1. Lavatory KOHLER K-20000 2. Faucot: BRADEY VERGE FAUCET METRO SERIES SS3 3300 3. Flow: 0.50 gpm 4. BATTERY STANDARD SENSOR  LV-2 1. LAVATORY WALL MOUNTED 1. Lavatory: ELKAY COMMERCIAL SENSOR SCRUBHANDWASH BATTERY POWERED DECK MOUNT FAUCET CHROME LKB721C 3. Flow: 0.50 gpm 1. Lavatory: NOLLER MOUNTED 1. Lavatory: NOLLER K-20000 2. Faucot: ELKAY COMMERCIAL SENSOR SCRUBHANDWASH BATTERY POWERED DECK MOUNT FAUCET CHROME LKB721C 3. Flow: 0.50 gpm 1. LAVATORY COUNTER MOUNTED 1. Lavatory: NOLLER K-20000 2. Faucot: ELKAY 4" CENTERSET WITH EXPOSED DECK LAVATORY FAUCET INTEGRAL SPOUT SINGLE CONTROL 4" WITHSTEIL ADE HANDLE CHROME 3. Flow: 0.50 gpm 1. Lavatory: COUNTER MOUNTED 1. Lavatory: ELKAY STANLESS STEEL 25" X 19-1/2" X 10-1/2" WALL HUNG SINGLE BOWL HAND WASH SINK EWS2520FC 2. Faucot: ELKAY COMMERCIAL SENSOR SCRUB-HANDWASH BATTERY POWERED DECK MOUNT FAUCET CHROME LKB721C 3. Flow: 1.50 gpm 1. Lavatory: MALL-HUNG 2. Faucot: ELKAY "CENTERSET WITH EXPOSED DECK LAVATORY FAUCET INTEGRAL SPOUT SINGLE CONTROL 4" WHISTELADE HANDLE CHROME 3. Flow: 0.50 gpm 4. Flow: 0.50 gpm 5. Flow: 0.50 gpm 6. Flow: 0.50 gpm 7. Fl		2"	2"
1. Lavatory: ELKAY STAINLESS STEEL 18-34" X 15-12" X 13" SINGLE BOWL WALL HUNG HANDWASH SINK 2. Faucet ELKAY COMMERCIAL SENSOR SCRUBHANDWASH BATTERY POWERED DECK MOUNT FAUCET CHROME LKB721C 3. Flow: 1.50 gpm 1. Lavatory COUNTER MOUNTED 1. Lavatory KOMLER M. 20000 2. Faucet ELKAY 4" CENTERSET WITH EXPOSED DECK LAVATORY FAUCET INTEGRAL SPOUT SINGLE CONTROL 4" WIRISTBLADE HANDLE CHROME 3. Flow: 0.50 gpm 1. Lavatory: CLKAY STAINLESS STEEL 25" X 19-1/2" X 10-1/2" WALL HUNG SINGLE BOWL HAND WASH SINK EWS250FC 1. Lavatory: ELKAY STAINLESS STEEL 25" X 19-1/2" X 10-1/2" WALL HUNG SINGLE BOWL HAND WASH SINK EWS250FC 1. Lavatory: ELKAY STAINLESS STEEL 25" X 19-1/2" X 10-1/2" WALL HUNG SINGLE BOWL HAND WASH SINK EWS250FC 1. Lavatory: ELKAY STAINLESS STEEL 25" X 19-1/2" X 10-1/2" WALL HUNG SINGLE BOWL HAND WASH SINK EWS250FC 1. Lavatory: ELKAY STAINLESS STEEL 25" X 19-1/2" X 10-1/2" WALL HUNG SINGLE BOWL HAND WASH SINK EWS250FC 1. Lavatory: ELKAY STAINLESS STEEL 25" X 19-1/2" X 10-1/2" WALL HUNG SINGLE BOWL HAND WASH SINK EWS250FC 1. Lavatory: AWSTAINLESS STEEL 25" X 19-1/2" X 10-1/2" WALL HUNG SINGLE BOWL HAND WASH SINK EWS250FC 1. Lavatory: AWSTAINLESS STAINLESS STEEL BOWL HAND WASH SINK EWS250FC 2. Faucet: ELKAY 4" CENTERSET WITH EXPOSED DECK LAVATORY FAUCET INTEGRAL SPOUT SINGLE CONTROL 4" WIRISTBLADE HANDLE CHROME 3. Flow: 0.50 gpm 4. Flow: 2.10 gpm 4. Flow: 2.10 gpm 4. Flow: 2.10 gpm 5. Flow: 0.50 gpm 6. Flow: 0.50 gpm 7. Flow: 0.50 gp	3/4"	2"	2"
1. Lavatory: KOHLER K-20000 2. Faucht: ELKAY d'CENTERSET WITH EXPOSED DECK LAVATORY FAUCET INTEGRAL SPOUT SINGLE CONTROL 4" WRISTBLADE HANDLE CHROME 3. Flow: 0.50 gpm  LV-4  LAVATORY COUNTER MOUNTED 1. Lavatory: ELKAY STAINLESS STEEL 25" X 19-1/2" X 10-1/2" WALL HUNG SINGLE BOWL HAND WASH SINK EWS2520FC 1. Lavatory: ELKAY COMMERCIAL SENSOR SCRUB/HANDWASH BATTERY POWERED DECK MOUNT FAUCET CHROME LKB721C 3. Flow: 1.50 gpm  LV-5  LAVATORY WALL-HUNG 1. Lavatory: MERICAN STANDARD - 0321,026 2. Faucet: ELKAY A' CHROME 3. Flow: 0.50 gpm  HB-1  HB-1  HOSE BIBB (MECH: EOUIP. ROOM) 1. Fixture: Zum 21341/2 required). integral stops, and vacuum breaker threaded outlet, mount faucet 36" A.F.F. 2. Fixture: Chicago Faucet #815-VBCP, integral stops, and vacuum breaker threaded outlet, mount faucet 36" A.F.F.  HB-2  HB-2  HOSE BIBB (WITH HOT WATER) 1. LEONARD THERNOSTATIC HOSE STATION MODEL THS: 25-VBD-CW (PANEL-MOUNT), WITH INLET HOT AND COLD CHECK AND STOP VALVES, OUTLET DIAL THERMOMETER, BACKFLOW PREVENTER AND A STAILESS STEEL HOSE RACK. 2. PROVIDE COMPLETE WITH LEONARD MODEL N2-SS NOZZLE AND LEONARD MODEL 25-HDH 25 FT. 3/4"  HEAVY DUTY HOSE.  MS-1  MS-1  MGP SINK 1. Manufacturer: STERN WILLIAMS + CHICAGO 3/4"  LEONARD THERNOSTATIC HOSE STATION MODEL THS: 25-VBD-CW (PANEL-MOUNT), WITH INLET HOT AND COLD CHECK AND STOP VALVES, OUTLET DIAL THERMOMETER, BACKFLOW PREVENTER AND A STAILESS STEEL HOSE RACK. 2. PROVIDE COMPLETE WITH LEONARD MODEL N2-SS NOZZLE AND LEONARD MODEL 25-HDH 25 FT. 3/4"  HEAVY DUTY HOSE.  MS-1  U-1  URINAL (HANDICAPPED) 1. Manufacturer: STERN WILLIAMS + CHICAGO 897-CRCF 3. Flow: 0.50 gpm 4. Provide carrier by ZURN.  MS-2  MOP SINK 1. 26"W X 38" L X 6" D STAINLESS STEEL BASIN WITH NOTHCED FRONT ACCESS. ADVANCE TABCO CUSTOM SIZE OR  3/4"  U-1  URINAL (HANDICAPPED) 1. Manufacturer: TOTO 10 1. Manufacturer: TOTO 11 1. FIXTURE: FREEDOM 40" X 39" ADA TRANSFER SHOWER	3/4"	2"	2"
1. Lavatory: ELKAY STAINLESS STEEL 25" X 19-1/2" WALL HUNG SINGLE BOWL HAND WASH SINK EWS2520FC 2. Faucet: ELKAY COMMERCIAL SENSOR SCRUB/HANDWASH BATTERY POWERED DECK MOUNT FAUCET CHROME LKB721C 3. Flow: 1.50 gpm  LV-5  LAVATORY WALL-HUNG 1. Lavatory: MARENICAN STANDARD - 0321.026 2. Faucet: ELKAY 4" CENTERSET WITH EXPOSED DECK LAVATORY FAUCET INTEGRAL SPOUT SINGLE CONTROL 4" WRISTBLADE HANDLE CHROME 3. Flow: 0.50 gpm  HB-1  HOSE BIBB (MECH. EQUIP. ROOM) 1. Fixture: Zum Z1341(2 required), integral stops, and vacuum breaker threaded outlet, mount faucet 36" A.F.F. 2. Fixture: Chicago Faucet #815-VBCP, integral stops, and vacuum breaker threaded outlet, mount faucet 36" A.F.F.  HB-2  HOSE BIBB (WITH HOT WATER) 1. LEDNARD THERMOSTATIC HOSE STATION MODEL THS-25-VBD-CW (PANEL-MOUNT), WITH INLET HOT AND COLD CHECK AND STOP VALVES, OUTLET DIAL THERMOMETER, BACKFLOW PREVENTER AND A STAINLESS STEEL HOSE RACK, 2. PROVIDE COMPLETE WITH LEONARD MODEL N2-SS NOZZLE AND LEONARD MODEL 25HDH 25 FT. 3/4" HEAVY DUTY HOSE.  MS-1  MS-1  MS-1  MS-1  MS-2  MOP SINK 1. Manufacturer: STERN WILLIAMS SB-900 + CHICAGO 897-CRCF 3. Flow: 0.50 gpm 4. Provide carrier by ZURN.  MS-2  MOP SINK 1. 26 W X 38" L X 6" D STAINLESS STEEL BASIN WITH NOTHCED FRONT ACCESS. ADVANCE TABCO CUSTOM SIZE OR 3/4"  U-1  UFRINAL (HANDICAPPED) 1. IMANUFACTURE: TOTO TEULA12#CP 4. Flow: 0.50 gpf 5. Provide carrier by ZURN.  SHOWER SHOWER 1. INSTRUMEN: FREEDOM 40" X 39" ADA TRANSFER SHOWER LEFT VALVE WALL, APFC36378F3PL 2. FAUCET: MEON HANDHELD, WALL MOUNTED SHOWERHEAD KIT 2.5 GPM CHROME  3/4"	3/4"	2"	2"
1. Lavatory: AMERICAN STANDARD - 0321.026   2. Faucet: ELKAY 4" CENTERSET WITH EXPOSED DECK LAVATORY FAUCET INTEGRAL SPOUT SINGLE CONTROL 4"   2. Faucet: ELKAY 4" CENTERSET WITH EXPOSED DECK LAVATORY FAUCET INTEGRAL SPOUT SINGLE CONTROL 4"   3. Flow: 0.50 gpm	3/4"	2"	2"
1. Fixture: Zum Z1341(2 required), integral stops, and vacuum breaker threaded outlet, mount faucet 36" A.F.F. 2. Fixture: Chicago Faucet #815-VBCP, integral stops, and vacuum breaker threaded outlet, mount faucet 36" A.F.F.  HB-2 HOSE BIBB (WITH HOT WATER) 1. LEONARD THERMOSTATIC HOSE STATION MODEL THS-25-VBD-CW (PANEL-MOUNT), WITH INLET HOT AND COLD CHECK AND STOP VALVES, OUTLET DIAL THERMOMETER, BACKFLOW PREVENTER AND A STAINLESS STEEL HOSE RACK. 2. PROVIDE COMPLETE WITH LEONARD MODEL N2-SS NOZZLE AND LEONARD MODEL 25HDH 25 FT. 3/4" HEAVY DUTY HOSE.  MS-1 MOP SINK 1. Manufacturer: STERN WILLIAMS + CHICAGO 2. Model: STERN WILLIAMS SB-900 + CHICAGO 897-CRCF 3. Flow: 0.50 gpm 4. Provide carrier by ZURN.  MS-2 MOP SINK 1: 26"W X 36" L X 6" D STAINLESS STEEL BASIN WITH NOTHCED FRONT ACCESS. ADVANCE TABCO CUSTOM SIZE OR SIMILAR  U-1 URINAL (HANDICAPPED) 1. Manufacturer: TOTO 2. Model: TOTO UT447/E 3. Flushometer: TOTO TEU1LA12#CP 4. Flow: 0.50 gpf 5. Provide carrier by ZURN.  SHOWER 1. FIXTURE: FREEDOM 40" X 39" ADA TRANSFER SHOWER LEFT VALVE WALL, APFQ3637BF3PL 2. FAUCET: MEON HANDHELD, WALL MOUNTED SHOWERHEAD KIT 2.5 GPM CHROME  3/4"	3/4"	2"	2"
1. LEONARD THERMOSTATIC HOSE STATION MODEL THS-25-VBD-CW (PANEL-MOUNT), WITH INLET HOT AND COLD CHECK AND STOP VALVES, OUTLET DIAL THERMOMETER, BACKFLOW PREVENTER AND A STAINLESS STEEL HOSE RACK.  2. PROVIDE COMPLETE WITH LEONARD MODEL N2-SS NOZZLE AND LEONARD MODEL 25HDH 25 FT. 3/4"  HEAVY DUTY HOSE.  MS-1 MOP SINK  1. Manufacturer: STERN WILLIAMS + CHICAGO 2. Model: STERN WILLIAMS SB-900 + CHICAGO 897-CRCF 3. Flow: 0.50 gpm 4. Provide carrier by ZURN.  MS-2 MOP SINK 1: 26"W X 36" L X 6" D STAINLESS STEEL BASIN WITH NOTHCED FRONT ACCESS. ADVANCE TABCO CUSTOM SIZE OR SIMILAR  U-1 URINAL (HANDICAPPED) 1. Manufacturer: TOTO 2. Model: TOTO UT447E 3. Flushometer: TOTO TEU1LA12#CP 4. Flow: 0.50 gpf 5. Provide carrier by ZURN.  SHOWER 1. FIXTURE: FREEDOM 40" X 39" ADA TRANSFER SHOWER LEFT VALVE WALL, APFQ3637BF3PL 2. FAUCET: MEON HANDHELD, WALL MOUNTED SHOWERHEAD KIT 2.5 GPM CHROME 3/4"			
1. Manufacturer: STERN WILLIAMS + CHICAGO 2. Model: STERN WILLIAMS SB-900 + CHICAGO 897-CRCF 3. Flow: 0.50 gpm 4. Provide carrier by ZURN.  MS-2 MOP SINK 1: 26"W X 36" L X 6" D STAINLESS STEEL BASIN WITH NOTHCED FRONT ACCESS. ADVANCE TABCO CUSTOM SIZE OR SIMILAR  U-1 URINAL (HANDICAPPED) 1. Manufacturer: TOTO 2. Model: TOTO UT447E 3. Flushometer: TOTO TEU1LA12#CP 4. Flow: 0.50 gpf 5. Provide carrier by ZURN.  SHOWER SHOWER 1. FIXTURE: FREEDOM 40" X 39" ADA TRANSFER SHOWER LEFT VALVE WALL, APFQ3637BF3PL 2. FAUCET: MEON HANDHELD, WALL MOUNTED SHOWERHEAD KIT 2.5 GPM CHROME  3/4"	3/4"		
1: 26"W X 36" L X 6" D STAINLESS STEEL BASIN WITH NOTHCED FRONT ACCESS. ADVANCE TABCO CUSTOM SIZE OR SIMILAR  U-1  URINAL (HANDICAPPED) 1. Manufacturer: TOTO 2. Model: TOTO UT447E 3. Flushometer: TOTO TEU1LA12#CP 4. Flow: 0.50 gpf 5. Provide carrier by ZURN.  SHOWER 1. FIXTURE: FREEDOM 40" X 39" ADA TRANSFER SHOWER LEFT VALVE WALL, APFQ3637BF3PL 2. FAUCET: MEON HANDHELD, WALL MOUNTED SHOWERHEAD KIT 2.5 GPM CHROME  3/4"	3/4"	4"	2"
1. Manufacturer: TOTO 2. Model: TOTO UT447E 3. Flushometer: TOTO TEU1LA12#CP 4. Flow: 0.50 gpf 5. Provide carrier by ZURN.  SHOWER 1. FIXTURE: FREEDOM 40" X 39" ADA TRANSFER SHOWER LEFT VALVE WALL, APFQ3637BF3PL 2. FAUCET: MEON HANDHELD, WALL MOUNTED SHOWERHEAD KIT 2.5 GPM CHROME  3. Flushometer: TOTO 2. Model: TOTO UT447E 3. Flushometer: TOTO 3. Flushometer: TOTO 3. Flushometer: TOTO 4. Flushometer: TOTO 5. Provide carrier by ZURN.  SHOWER 5. Provide carrier by ZURN.  3. Flushometer: TOTO TEU1LA12#CP 4. Flow: 0.50 gpf 5. Provide carrier by ZURN.  3. Flushometer: TOTO TEU1LA12#CP 4. Flow: 0.50 gpf 5. Provide carrier by ZURN.	3/4"	4"	2"
SH-1  1. FIXTURE: FREEDOM 40" X 39" ADA TRANSFER SHOWER LEFT VALVE WALL, APFQ3637BF3PL 2. FAUCET: MEON HANDHELD, WALL MOUNTED SHOWERHEAD KIT 2.5 GPM CHROME  3/4"		2"	2"
	3/4"	3"	2"
SINK COUNTER MOUNTED  1. FIXTURE: ELKAY LUSTERTONE CLASSIC STAINLESS STEEL SINGLE BOWL UNDERMOUNT ADA SINK WITH PERFECT DRAIN  2. FAUCET: ELKAY AVADO SINGLE HOLE KITCHEN FAUCET WITH PULL-DOWN SPRAY AND FORWARD AND FORWARD ONLY  LEVER HANDLE  3. Flow: 1.8 gpm  4. FIXTURE SIZE 21-1/2" X 18-1/2" X 5-3/8"	3/4"	2"	2"
SINK COUNTER MOUNTED  1. LAVATORY: ELKAY LUSTERTONE CLASSIC STAINLESS STEEL SINGLE BOWL UNDERMOUNT ADA SINK WITH PERFECT DRAIN  2. FAUCET: ELKAY SINGLE HOLE WITH CONCEALED DECK LAMINAR FLOW FAUCET WITH 5" GOOSENECK SPOUT 4"  WRISTBLADE HANDLES CHROME  3. K-50 DECK MOUNTED FAUCET INCLUDED.	3/4"	2"	2"
SINK Refer to the Architecural Drawings LOOSE KEY SUPPLY STOPS AND P-TRAP ASSEMBLY PLUMBING CONTRACTOR TO PROVIDE ANY ADDITIONAL ACCESSORIES FOR A COMPLETE INSTLATION  3/4"	3/4"	2"	2"
SINK 1. LAVATORY: ELKAY RNSF8236LR OR APPROVED EQUAL, BOWL SIZE 18 X 24" X 12" DEEP 16 GAUGE TYPE 304 STAINLESS STEEL, LEFT AND RIGHT DRAINBOARDS, 8" BACKSPLASH. 2. FAUCET: CHICAGO FAUCET GN12ASWGJKABCP, CHROME PLATE FINISHED, SWING GOOSENECK SPOUT WITH CHICAGO FAUCET 786-TWLESSSPTABCP WRISTBLADE HANDLES, 1.5 GPM LAMINAR FLOW IN BASE OF SPOUT. 3. FAUCET: CHICAGO FAUCET 613-ALESAB DECK MOUNTED SINGLE HOLE ADAPTA-FAUCET WITH CHICAGO FAUCET 919- SLVBABCP PRE-RINSE FITTING, RISER WITH SPRING GUIDE, AND FLEXIBLE STAINLESS STEEL HOSE WITH INSULATED HANDLES. 5. PROVIDE: CHICAGO FAUCET 834-EPABCP REMOTE SPOUTS AND VALVES, PEDAL BOX WITH EXTENDED FOOT PEDALS. 6. PROVIDE: McGUIRE NO. H175LK 1/2" X 3/8" LOOSE KEY SUPPLY STOPS, JUST J-35-BLA-316-2 LEVER HANDLE DRAIN WITH CAST TYPE 316 STAINLESS STEEL BODY, TYPE 316 STAINLESS STEEL FLAT STRAINER, 5" DEEP SEAL TRAP. 7. INSTALL FAUCET 2 IN ONE BOWL AND FAUCET 3 IN THE OTHER (WILL COORDINATE TO FIND WHICH BOWL FOR EACH FAUCET)	3/4"	2"	2"
SK-5  SINK  1. LAVATORY: ELKAY WELDBIT STAINLESS STEEL 72" X 27-1/2" X 14" FLOOR MOUNT, SINGLE COMPARTMENT SCULLERY SINK WITH DRAINBOARD 24" X 24" BASIN 2. FAUCET: CHICAGO FAUCET GN12ASWGJKABCP, CHROME PLATE FINISHED, SWING GOOSENECK SPOUT WITH CHICAGO FAUCET 786-TWLESSSPTABCP WRISTBLADE HANDLES, 1.5 GPM LAMINAR FLOW IN BASE OF SPOUT.	3/4"	2"	2"
WH-1 WALL HYDRANT (NON-FREEZE) 1. Fixture: Zurn WOODFORD B65			
WM-1 WASHING MACHINE SUPPLY AND DRAIN BOX 1. Fixture: Water Tite Washer Box #W4700CP. Provide one McGuire #8904C P-trap in wall to serve supply Box. Mount Box 42" A.F.F. to bottom.  WC-1 WATER CLOSET WALL MOUNTED  1.1/4"	3/4"	2" 	2"
1. Manufacturer: TOTO 2. Model: TOTO CT708U 3. Flushometer: TOTO TET1LA32#CP 4. Flow: 1.28 gpf 5. Provide carrier by ZURN		7	
WC-1A  WATER CLOSET WALL MOUNTED (HANDICAPPED)  1. Manufacturer: TOTO 2. Model: TOTO CT708U 3. Flushometer: TOTO TET1LA32#CP 4. Flow: 1.28 gpf 5. Provide carrier by ZURN		4"	2"
FS-1  FLOOR SINK  1. Manufacturer: zurn  2. Model: 1901  3. Body Material: Duco Cast Iron  4. Top Cover: 8" by 8" Square  5. Grate or Strainer Material: Cast Iron  6. Duty: Medium  7. Note: Provide trap guard insert all floor drains (by pro vent manufacturer)		4"	2'
FD-1  FLOOR DRAIN (REGULAR - GENERAL PURPOSE)  1. Fixture: Zurn #ZN415-Y-P cast iron floor with sediment bucket and polished nickel bronze top, adjustable, strainer and flashing clamp device if drain is installed above slab on grade. Provide trap primer connections. Size of drain as shown on drawings.		SEE PLANS	2"
FD-2 FLOOR DRAIN (EQUIPMENT ROOMS)  1. Fixture: Zurn #ZN541-P round, cast iron, 12" diameter drain with sediment bucket, flange and clamp device if drain is installed above slab on grade. Provide trap primer connections. Size of drain as shown on drawings.		SEE PLANS	2"
TD-1  TRENCH DRAIN (HEAVY DUTY)  1. Fixture: Zurn #ZN665-VP Dura-Coated cast iron deep sump body trench drain with bottom outlet, integral seepage pan, polished stainless steel heavy duty vandal-proof secured top.  2. Provide required number of additional sections with outlets as required by length of trench drain shown on the drawings.		SEE PLANS	2"
TG-1 TRAP GUARD 1. Fixture: Provent Systems #TG series.		SEE PLANS	2"
GH-1 GROUND HYDRANT (NON-FREEZE) 1. Fixture: Zurn Z1360 GROUND HYDRANT			
LF-1 LIXIT FIXTURE FOR ANIMAL WATERING  1. Fixture: LF - 70  2. Non-freeze resistent for external locations  OVER USAR NOSE REAL (NECROPON)			
HB-1 OVERHEAD HOSE REAL (NECROPSY) 1. Fixture: REELCRAFT 5635 OLPSW5 - 3/8" X 35' PRE-RINSE HOSE REEL	3/4"		

# DOMESTIC WATER HEATER SCHEDULE

A. HEATER WITH BRONZE CIRCULATING PUMP(S) AND STARTER(S). B. CONDENSATE NEUTRALIZATION KIT.

C. MODBUS COMMUNICATIONS.

D. BMS GATEWAY TO LON OR BACNET. E. ALARM BELL ON HEATER.

F. M7 CALIFORNIA CODE FIRING CONTROL SYSTEM. G. CONCENTRIC VENT KIT WITH APPLICABLE WALL OR ROOF CAP.

GREASE INTERCEPTOR SCHEDULE


ESIGNATION	SERVICE	MANUFACTURER	MODEL NUMBER	MODEL NUMBER	EWT	LWT	INPUT [BTU/h]	COI	ITROL CIR	CUIT	RECOVERY	THERMAL	D	IMENSION	S
LSIGNATION	SETTVICE	WANDI ACTORLI	WODEL NOWBEN	°F	°F	[1000 BTU/h = 1 CFH]	Α	٧	PH	[GPH]	EFFICIENCY	DIAM.	HEIGTH	WEIGHT	
GWH-01	HOT WATER	AO SMITH	GDHE-75 Vertex	40	140	100	5	208	2	129	96%	28"	65"	382 pounds	
GWH-02	HOT WATER	AO SMITH	GDHE-75 Vertex	40	140	100	5	208	2	129	96%	28"	65"	382 pounds	


# PUMP SCHEDULE - PLUMBING SYSTEMS

	DESIGNATION	MANUFACTURER	MODEL NUMBER	GPM	TOTAL HEAD PSI	MOTOR HP	ELECTR VOLTAGE		REMARKS
A	RCP-1	GRUNDFOS	MAGNA1 32-60	10	9	1	208	3	B & G 60 SERIES (ECM); AUTOMATIC TIMER KIT #TC-1; AQUASTAT #AQS-3/4. THE AQUASTAT SHALL PROVIDE THERMOSTAT CONTROL TO THE RECIRC. PUMP TO TURN OFF AT 120°F WATER TEMPERATURE AND TURN ON AT 110°F WATER TEMPERATURE.
	* PLUMBING E THE NEC.	EQUIPMENT SHALL E	BE LISTED, LABELE	ED, AND MA	RKED FOR I	JSE BY AN	N APPROVE	D THIRI	D-PARTY CERTIFICATION AGENCY AND IN ACCORDANCE WITH THE REQUIREMENTS OF

### DOMESTIC HOT WATER EXPANSION TANK SCHEDULE

	CATIONS FOR ADDIT	TIONAL REQUIREMENT CONCRETE PAD BELO	REMARKS: A. ASME RATED.			
DESIGNATION	SERVICE	MANUFACTURER	MODEL NUMBER	TANK VOLUME GALLONS	INCOMING PRESSURE	REMARKS
ET-1	HOT WATER	WESSELS	TXA-1000	264	140	

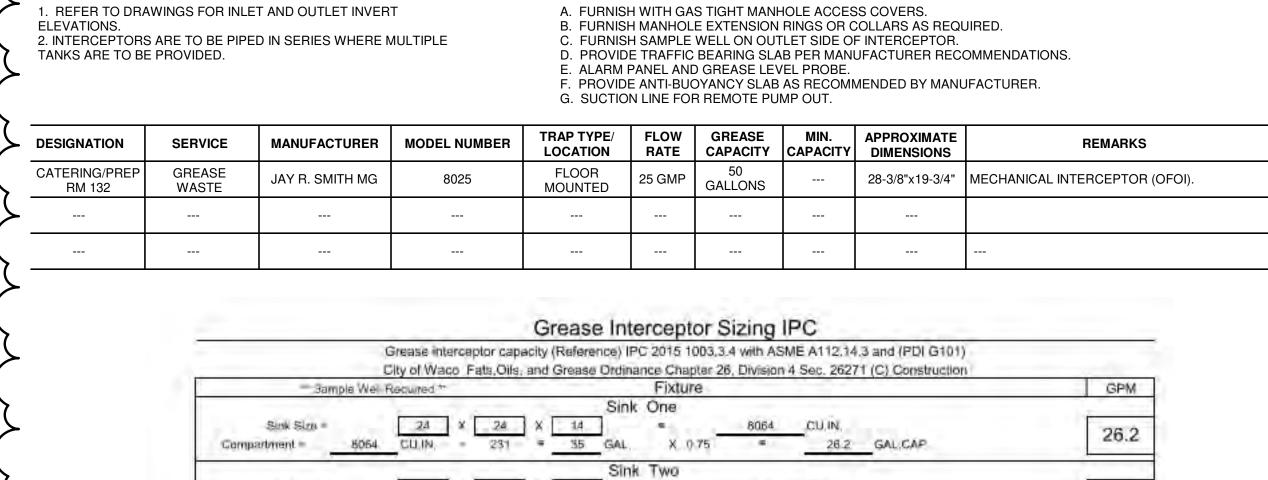

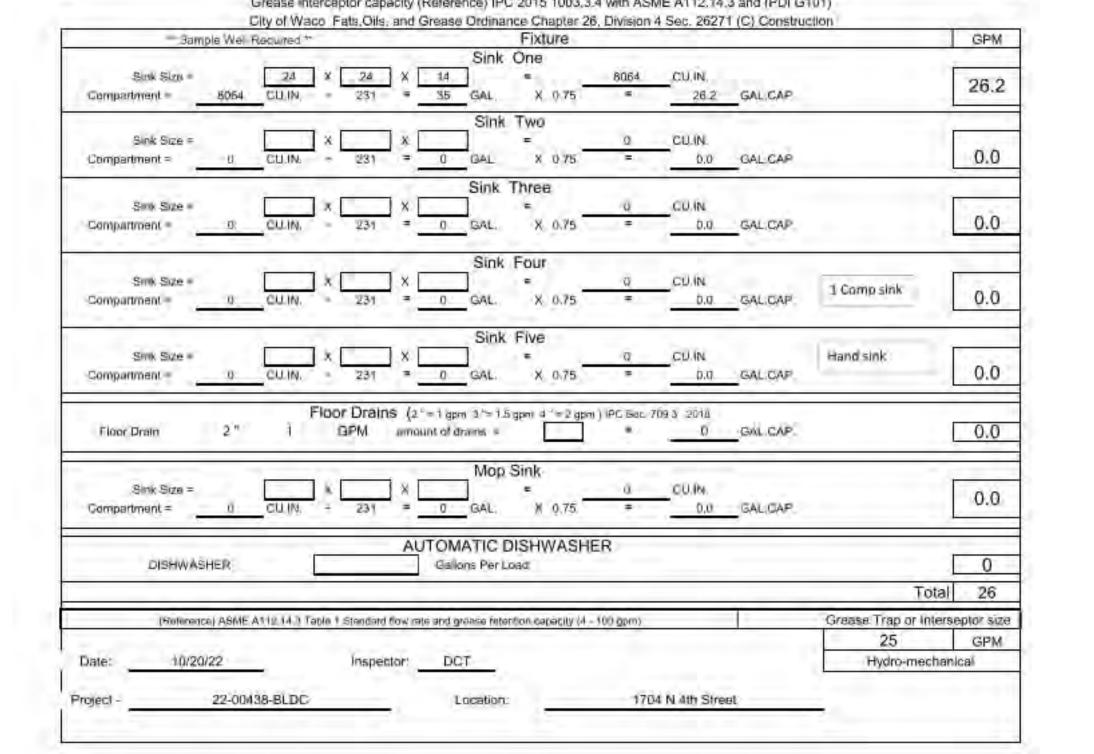

# Perkins&Will

1001 McKinney Suite 1300 Houston, TX 77002 t 713.366.4000 f 713.528.3339 www.perkinswill.com

CONSULTANTS WALKER PARTNERS, LLC 823 WASHINGTON AVENUE, SUITE 100, WACO, TEXAS 76701

ENSIGHT HAYNES WHALEY 12603 SW FREEWAY, SUITE 603, STAFFORD, TEXAS 77477

AFFILIATED ENGINEERS, INC. ONE GREENWAY PLAZA, SUITE 150, HOUSTON, TEXAS 77046

CITY OF WACO P.O. BOX 2570, WACO, TX 76702



Texas Registered Engineering Firm F-8301



# **CAMERON PARK ZOO: EDUCATION CENTER & VET HOSPITAL**

1701 N. 4TH STREET WACO, TX 76707



**CITY OF WACO CAMERON PARK ZOO** 

P.O. BOX 2570, WACO, TX

**KEYPLAN** VET HOSPITAL

**EDUCATION CENTER** 



Job I	Number	185236.000
MARK	ISSUE	DATE
2	ADDENDUM #2	10/25/2022
1	PERMIT RESPONSE_v1	9/29/2022

**PLUMBING SCHEDULES** 

SHEET NUMBER

P62-01

© 2020 Perkins and Will

